


Drain: MARTHA DRAIN Drain #: 203
Improvement/Arm: MARTHA - SECTION 13
Operator: JRH Date: 1-28-04
Drain Classification: Urban/Rural Year Installed: 1985

GIS Drain Input Checklist

- Pull Source Documents for Scanning QA 1-28
- Digitize & Attribute Tile Drains N/A
- Digitize & Attribute Storm Drains QA 1-28
- Digitize & Attribute SSD QA 1-28
- Digitize & Attribute Open Ditch N/A
- Stamp Plans QA 1-28
- Sum drain lengths & Validate QA 1-28
- Enter Improvements into Posse QA 1-28
- Enter Drain Age into Posse Proj 3-2
- Sum drain length for Watershed in Posse Proj 3-2
- Check Database entries for errors QA 1-28

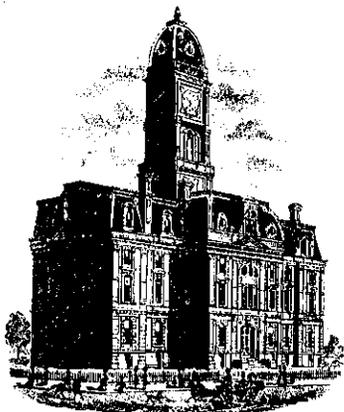

SURVEYOR'S OFFICE

Hamilton County

Kenton C. Ward, Surveyor

776-9626

Noblesville, Ind. 46060 December 26, 1984

TO: Hamilton County Drainage Board

RE: Masthead Drain, Section 13

Attached is a petition, Non-enforcement request, plans, calculations, quantity summary and assessment roll for the Masthead Drain, Section 13. I have reviewed the submittals and petition and have found each to be in proper form.

I have made a personal inspection of the land described in the petition. Upon doing so, I believe that the drain is practicable; will improve the public health, benefit a public highway and be of public utility; and that the costs, damages and expenses of the proposed drain will probably be less than the benefits accruing to the owners of land likely to be benefitted.


The drain will consist of the following:

12" RCP	441 L.F.
6" SSD	960 L.F.

The total length of the drain will be 1401 feet.

I recommend a maintenance assessment of \$20.00 per lot or block with \$2.00 per acre for roadways with this assessment the total annual assessment for this section will be \$506.00.

I recommend a hearing be set for the February 1985 meeting.

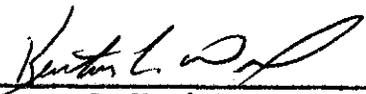
Kenton C. Ward-Surveyor

KCW/no *Filed January 14, 1985*
Hamilton County Drainage Board
Nancy Ellen Blodgett - Secretary

CERTIFICATE OF COMPLETION AND COMPLIANCE

TO: COUNTY SURVEYOR'S OFFICE, HAMILTON COUNTY
ATTN: Mr. Kenton Ward
FROM: Paul I. Cripe, Inc., Engineers
SUBJECT: Masthead Subdivision - Section 13

I hereby certify that

- 1) I am familiar with the plans and specifications for the above referenced project,
- 2) I have personally observed the completion of the above referenced project, and
- 3) To the best of my knowledge, information and belief, the above referenced project has been performed and completed in conformity with all plans and specifications, except as noted on "as-built" plans.


Signature Joseph A. Sharp Date October 1, 1985
Type or Printed Name Joseph A. Sharp
Business Address 7172 Graham Road
Indianapolis, IN 46250
Telephone 317-842-6777

Seal



Indiana Registration Number

15179

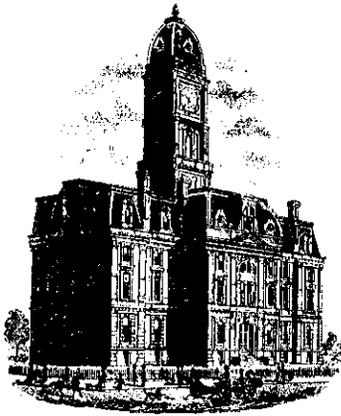

SURVEYOR'S OFFICE
Hamilton County

Kenton C. Ward, Surveyor

776-9626


Noblesville, Ind. 46060 December 31, 1985

TO: Hamilton County Drainage Board

RE: Masthead Drain, Section 13

Attached is a Certificate of Completion and Compliance, along with a as built drawing for the drainage facilities for Masthead, Section 13. On October 23, 1985, a final inspection was made of the subdivision and at time I found the section to be complete and acceptable. This section of the subdivision did not have a modification made to it. Therefore, as in my report of December 26, 1984 to the Board, the length for this section of the drain is 1,401 feet.

Also attached is a nonenforcement request which should be approved at this time.

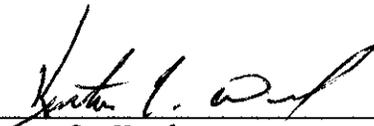



Kenton C. Ward
Hamilton County Surveyor

KCW/no

CONSTRUCTION PLANS

FOR

MASTHEAD SECTION 13

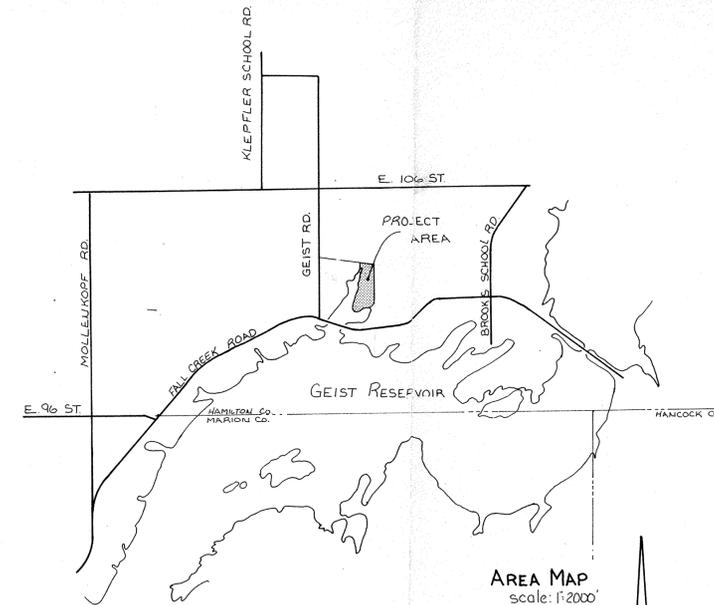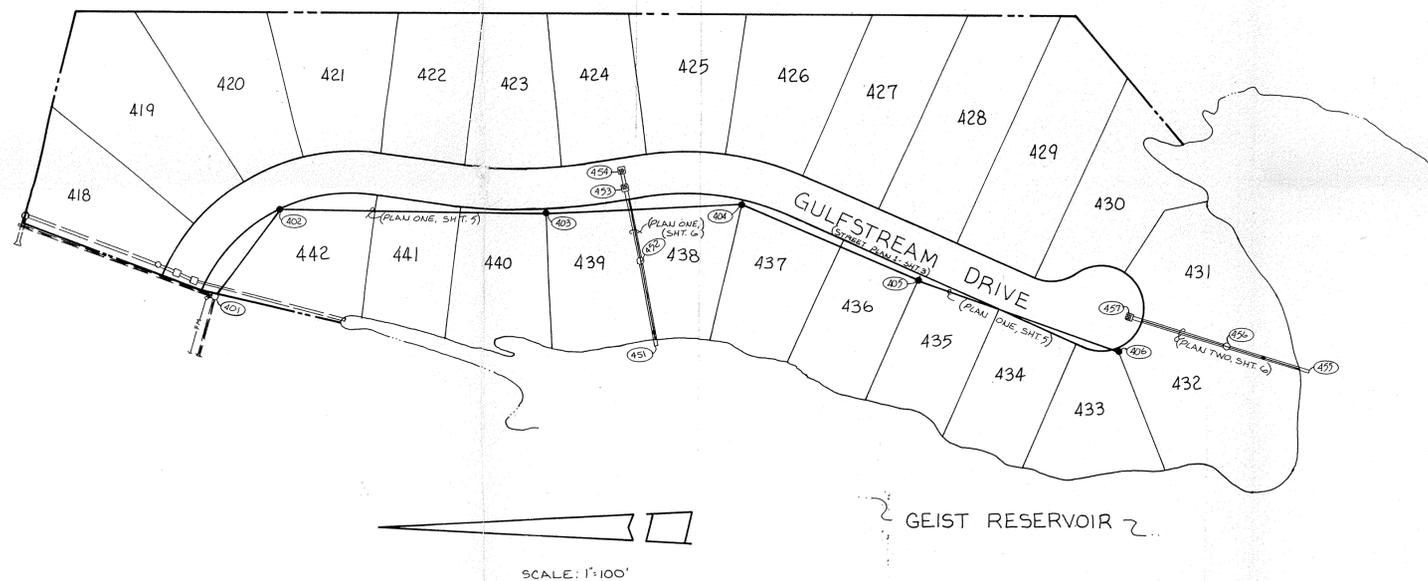

INDEX	
SHT.	DESCRIPTION
1	COVER SHEET
2	SITE DEVELOPMENT PLAN
3	STREET - PLAN & PROFILE
4	STREET - DETAIL
5	SANITARY SEWER - PLAN & PROFILE
6	STORM SEWER - PLAN & PROFILE
7	STANDARD DETAILS & SPECIFICATIONS
8	STANDARD DETAILS & SPECIFICATIONS
9	CLEARING LIMITS PLAN


BENCH MARKS	

REVISIONS	



This information was gathered based on information provided by the client and is not to be considered an independent survey.
 Entry Date: 1-28-04
 Entered by: JDH

CERTIFIED BY	REVISIONS	 PAUL I. CRIFE, INC. 7172 GRAHAM ROAD INDIANAPOLIS, INDIANA 46250 (317) 842-6777	TECH. CHK.	DRAWN BY	SCALE	DATE	CLIENT	DWG. TYPE	FILE NUMBER	SHEET
	DATE		10-10-84 REV PER NOBLESVILLE, TAC 10-31-84 REV SSD	• CIVIL ENGINEERING • LAND SURVEYING • ARCHITECTURE • LAND PLANNING	JWS noted 8-21-84 MASTHEAD-SEC. 13	DFTNG. CHK. DRAWING TITLE COVER SHEET	84100-00013 OF 9			

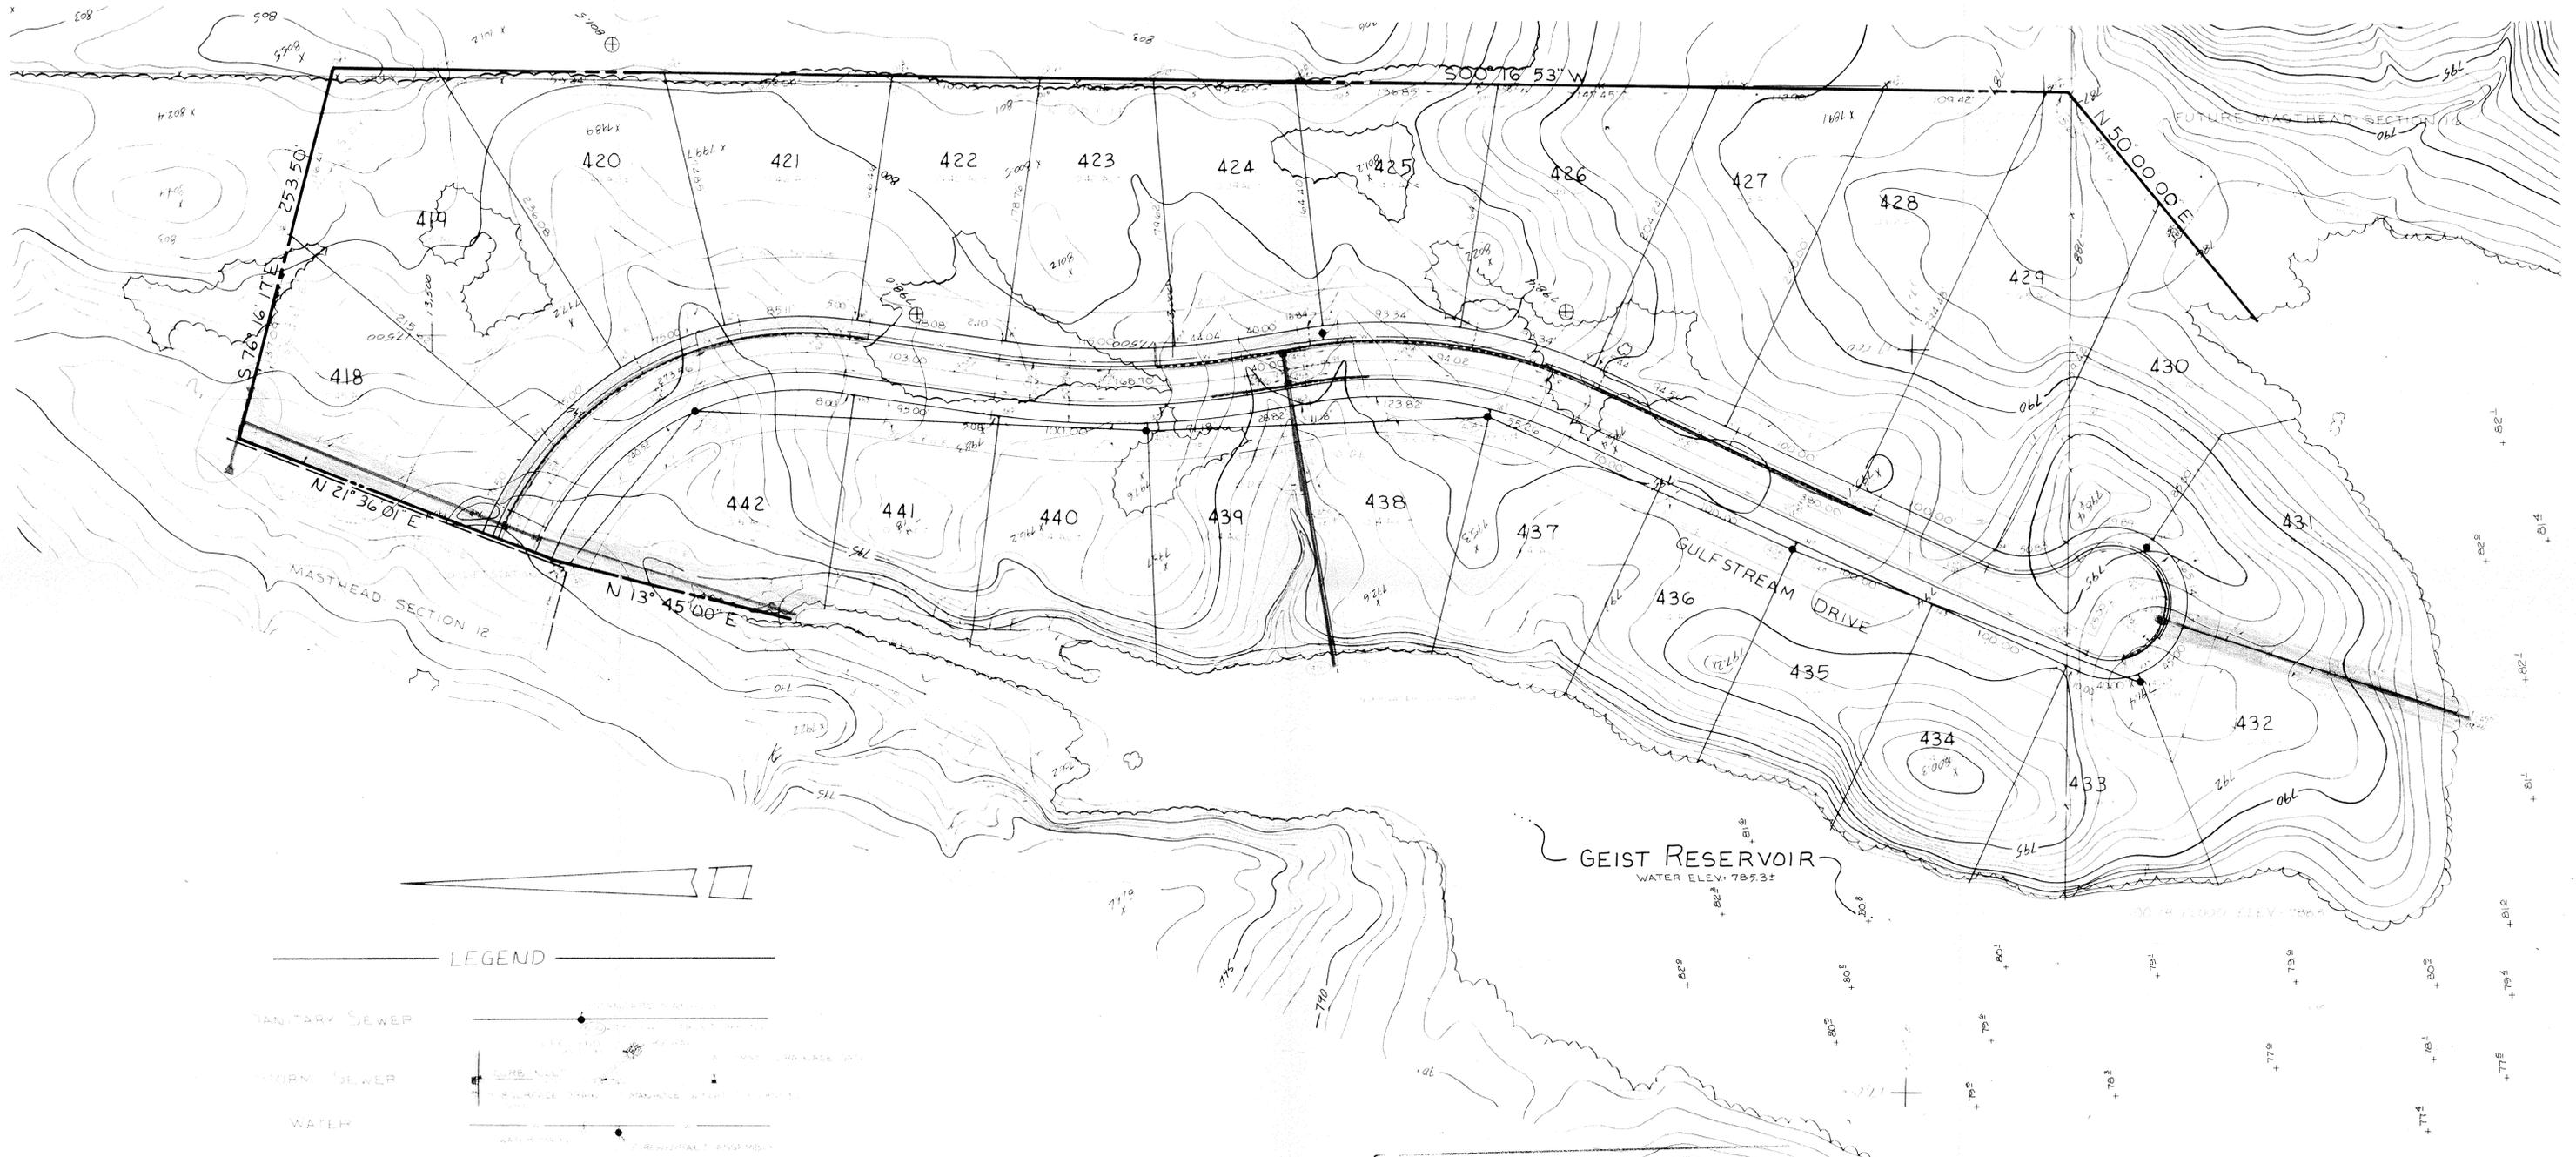

LEGEND

SANITARY SEWER

STORM SEWER

WATER

WATER TO BE INSTALLED BY HOMEOWNER

PAUL I. CRIFE, INC. SURVEYOR


Entry Date: 1-28-04

Entered by: JPH

NOTE: DIMENSIONS, BEARINGS & EASEMENTS ARE SHOWN FOR REFERENCE ONLY. DO NOT NECESSARILY DEPICT ACTUAL RECORDED INFORMATION. SEE RECORDED PLAT FOR EXACT INFORMATION.


CERTIFIED BY	REVISIONS	PAUL I. CRIFE, INC. 7172 GRAHAM ROAD INDIANAPOLIS, INDIANA 46250 (317) 842-6777	TECH. CHK.	DRAWN BY	SCALE	DATE	CLIENT	DWG. TYPE	FILE NUMBER	SHEET	
			DFTNG. CHK.	DRAWING TITLE	1"=50'	8-21-04	MASTHEAD-SEC 13				2
DATE			SITE DEVELOPMENT PLAN				JOB NUMBER		84100-00013		OF 9

NOTE: CUTS SHOWN ARE APPROXIMATE TAKEN FROM EXISTING GRADE TO INVERT OF PROPOSED PIPE

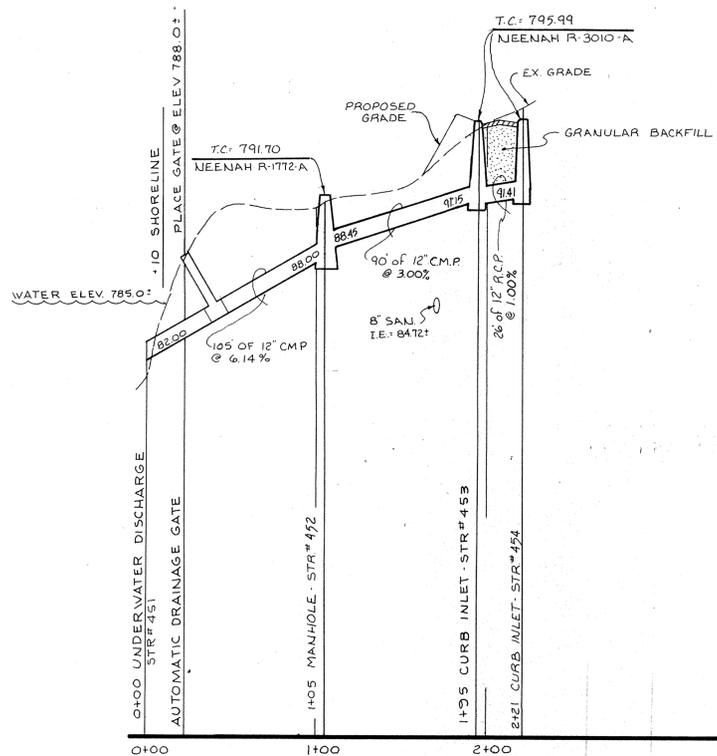


PROFILE ONE

SCALE: HORZ 1"=50'
VERT 1"=5'

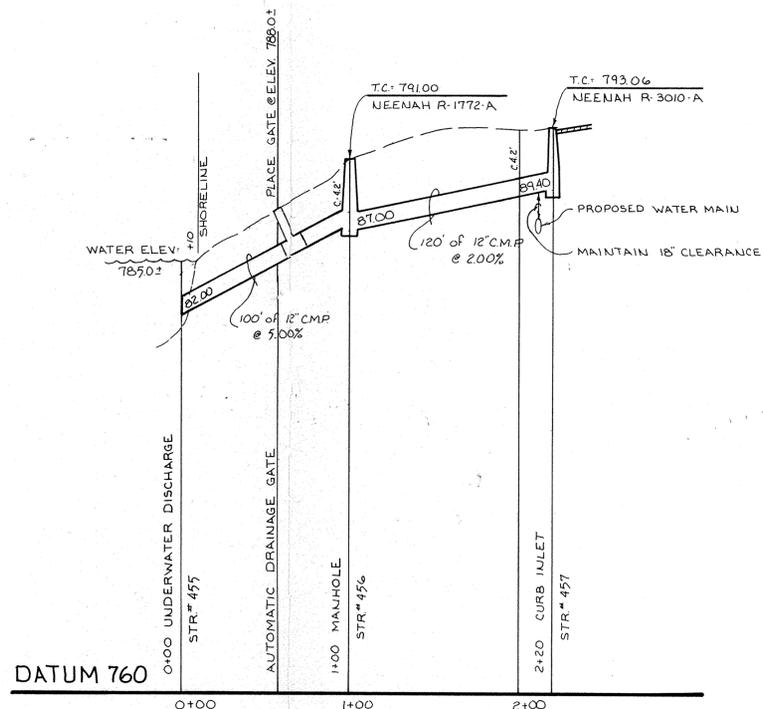


PROFILE TWO

SCALE: HORZ 1"=50'
VERT 1"=5'

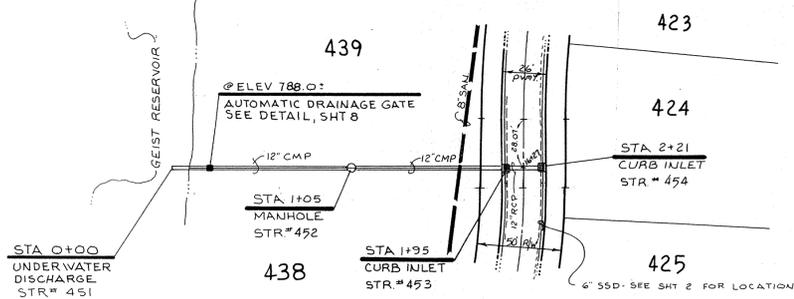


PLAN ONE

SCALE: 1"=50'

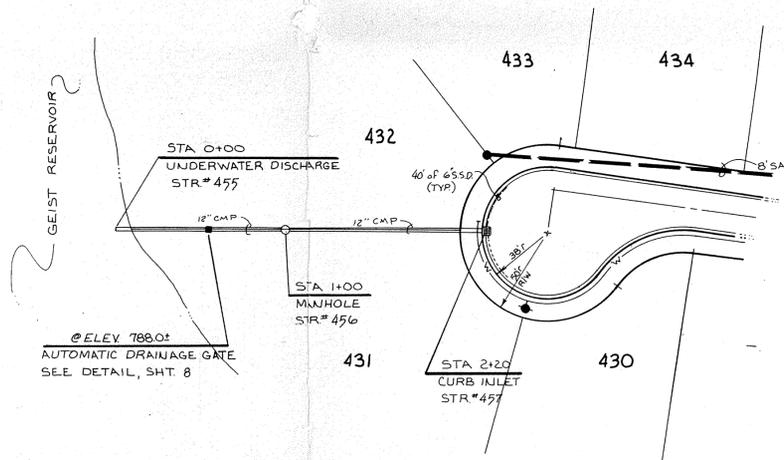

PLAN TWO

SCALE: 1"=50'

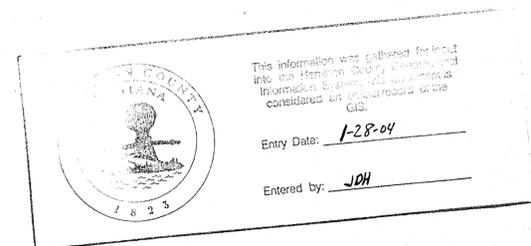

CERTIFIED BY	REVISIONS	 PAUL I. CRIFE, INC. 7172 GRAHAM ROAD INDIANAPOLIS, INDIANA 46250 (317) 842-6777	TECH. CHK.	DRAWN BY	SCALE	DATE	CLIENT	DWG. TYPE	FILE NUMBER	SHEET
			DFTNG. CHK.	DRAWING TITLE						
DATE				<i>JSB</i>	<i>noted</i>	8-21-84	MASTHEAD 13			6
				STORM SEWER - PLAN & PROFILE				JOB NUMBER	84100-00013	OF 9