Drain: CROOKED CREEK DRAIN **Drain #:** 250

Improvement/Arm: THE VILLAGES AT WESTON PLACE - SECTION 2

Operator: JDH **Date:** 12-4-03

Drain Classification: **Urban/Rural** **Year Installed:** 1996

GIS Drain Input Checklist

- Pull Source Documents for Scanning — JDH 12-4
- Digitize & Attribute Tile Drains — N/A
- Digitize & Attribute Storm Drains — JDH 12-4
- Digitize & Attribute SSD — JDH 12-4
- Digitize & Attribute Open Ditch — N/A
- Stamp Plans — JDH 12-4
- Sum drain lengths & Validate — JDH 12-4
- Enter Improvements into Posse — JDH 12-4
- Enter Drain Age into Posse — [signature] 12-12
- Sum drain length for Watershed in Posse — [signature] 12-12
- Check Database entries for errors — JDH 12-4

This copy printed from the Digital Archive of the Hamilton County Surveyor's Office; One Hamilton Co. Square, Ste. 188, Noblesville, In 46060

Gasb 34 Footages for Historical Cost
Drain Length Log

Drain-Improvement: CROOKED CREEK DRAIN - THE VILLAGES AT WESTON PLACE - SECTION 2

Drain Type:	Size:	Length (SURVEYORS REPORT)	Length (DB Query)	Length Reconcile	If Applicable Price:	If Applicable Cost:
SSD	6"	5258.62'	5,258.62'	ø		
RCP	12"	254'	254'	ø		
	15"	331'	331'	ø		
	18"	218.5'	218.5'	ø		
	24"	410'	410'	ø		
	27"	299'	299'	ø		
	30"	428'	428'	ø		
	33"	292'	292'	ø		
	36"	291'	291'	ø		
Sum:		7,782.12	7,782.12	ø		

Final Report: _____

Comments:

This copy printed from the Digital Archive of the Hamilton County Surveyor's Office; One Hamilton Co. Square, Ste. 188, Noblesville, In 46060

SURVEYOR'S OFFICE

Hamilton County

Kenton C. Ward, Surveyor
Phone (317) 776-8495
Fax (317) 776-9628

Suite 146
One Hamilton County Square
Noblesville, Indiana 46060-2230

June 3, 1996

TO: Hamilton County Drainage Board

RE: Crooked Creek Drain-The Villages @ Weston Place-Section 2

Attached is a petition, non-enforcement request, plans, calculations, quantity summary and assessment roll for the **Weston Place-Section 2 Arm-Crooked Creek Drain**. I have reviewed the submittals and petition and have found each to be in proper form.

I have made a personal inspection of the land described in the petition. Upon doing so, I believe that the drain is practicable; will improve the public health; benefit a public highway and be of public utility; and that the costs, damages and expenses of the proposed drain will probably be less than the benefits accruing to the owners of land likely to be benefited. The drain will consist of the following:

6"	SSD	5036 ft	27"	RCP	332 ft
12"	RCP	253 ft	30"	RCP	430 ft
15"	RCP	421 ft	33"	RCP	294 ft
18"	RCP	225 ft	36"	RCP	291 ft
24"	RCP	412 ft			

The total length of the drain will be 7,694 feet.

The subsurface drains (SSD) to be part of the regulated drain are those located under the curbs. Only the main SSD lines which are located within the right of way are to be maintained as regulated drain. Laterals for individual lots will not be considered part of the regulated drain.

This copy printed from the Digital Archive of the Hamilton County Surveyor's Office; One Hamilton Co. Square, Ste. 188, Noblesville, In 46060

I have reviewed the plans and believe the drain will benefit each lot equally. Therefore, I recommend each lot be assessed equally. I also believe that no damages will result to landowners by the construction of this drain. I recommend a maintenance assessment of $ 30.00 per lot, $5.00 per acre for roadways, with a $ 30.00 minimum. With this assessment the total annual assessment for this drain/this section will be $ 1186.95 .

I believe this proposed drain meets the requirements for Urban Drain Classification as set out in IC 36-9-27-67 to 69. Therefore, this drain shall be designated as an Urban Drain.

I recommend that upon approval of the above proposed drain that the Board also approve the attached non-enforcement request. This request is for the reduction of the regulated drain easement to those easement widths as shown on the secondary plat for The Villages @ Weston Place-Section 2 as recorded in the office of the Hamilton County Recorder.

I recommend the Board set a hearing for this proposed drain for July 22, 1996.

Kenton C. Ward
Hamilton County Surveyor
KCW/no

This copy printed from the Digital Archive of the Hamilton County Surveyor's Office; One Hamilton Co. Square, Ste. 188, Noblesville, In 46060

SCHEERS INCORPORATED
5650 S. BRAINARD, LA GRANGE, ILLINOIS 60525 708/352-6282

FRONTIER INSURANCE COMPANY
MONTICELLO, NEW YORK
(A Stock Company)

6-11-96

SUBDIVISION BOND

Bond No.: 89106 Principal Amount: $124,400.00

KNOW ALL MEN BY THESE PRESENTS, that we K. - E. PROPERTIES, LLC 1041 West Main Street Carmel, IN 46032 as Principal, and FRONTIER INSURANCE CO. 195 Lake Louise Marie Road Rock Hill, NY 12775-8000 a New York Corporation, as Surety, are held and firmly bound unto HAMILTON COUNTY BOARD OF COMMISSIONERS 1 Hamilton County Sq., Ste. 146 Noblesville, IN 46060-2230 in the penal sum of One Hundred Twenty Four Thousand Four Hundred and 00/100 ---------- (Dollars) ($ 124,400.00 ---------), lawful money of the United States of America, for the payment of which well and truly to be made, we bind ourselves, our heirs, executors, administrators, successors and assigns, jointly and severally, firmly by these presents.

WHEREAS, K. - E. PROPERTIES, LLC has agreed to construct in VILLAGE AT WESTON PLACE SECTION 2 Subdivision, in HAMILTON COUNTY BOARD OF COMMISSIONERS the following improvements:

Storm Sewer System Including Pipe, Inlets, Manhole End Sections, Subsurface Drains, Rip-Rap, Bedding and Backfill

This copy printed from the Digital Archive of the Hamilton County Surveyor's Office; One Hamilton Co. Square, Ste. 188, Noblesville, In 46060

SCHEER'S INCORPORATED
5650 S. BRAINARD, LA GRANGE, ILLINOIS 60525 708/352-6282

FRONTIER INSURANCE COMPANY
MONTICELLO, NEW YORK
(A Stock Company)

FILE COPY

SUBDIVISION BOND

Bond No.: 89107 Principal Amount: $3,000.00

KNOW ALL MEN BY THESE PRESENTS, that we K. - E. PROPERTIES, LLC 1041 West Main Street Carmel, IN 46032 as Principal, and FRONTIER INSURANCE CO. 195 Lake Louise Marie Road Rock Hill, NY 12775-8000 a New York Corporation, as Surety, are held and firmly bound unto HAMILTON COUNTY BOARD OF COMMISSIONERS 1 Hamilton County Sq., Ste. 146 Noblesville, IN 46060-2230 in the penal sum of Three Thousand and 00/100 ---------- (Dollars) ($ 3,000.00 ----------), lawful money of the United States of America, for the payment of which well and truly to be made, we bind ourselves, our heirs, executors, administrators, successors and assigns, jointly and severally, firmly by these presents.

WHEREAS, K. - E. PROPERTIES, LLC has agreed to construct in VILLAGE AT WESTON PLACE SECTION 2 Subdivision, in HAMILTON COUNTY the following improvements:

Erosion Control

This copy printed from the Digital Archive of the Hamilton County Surveyor's Office; One Hamilton Co. Square, Ste. 188, Noblesville, In 46060

CERTIFICATE OF COMPLETION AND COMPLIANCE

Address of premises on which
land alteration was accomplished Northeast Corner 106th Street and Michigan Road

Inspection Date(s): _____ Permit No. _____

Relative to plans prepared by: Stoeppelwerth and Associates, Inc.

on 11/20, 1995.

I hereby certify that:

To the best of my knowledge, information and belief such land alteration has been performed and completed in conformity with the improved plan, except Swale Lots 107-110, 55-56

Signature David J Stoeppelwerth Date: 10-24-96

Typed Name: David J. Stoeppelwerth Phone: (317 849-5935

Business Address 9940 Allisonville Rd., P.O. Box 509007
Indianapolis, In. 46250

Surv. x Engr. ____ Arch. ___ Indiana Registration No. S0474 R.L.S. S0474

(SEAL)

10265COM/IWP/FORM

FILED

OCT 25 1996

OFFICE OF HAMILTON COUNTY SURVEYOR

This copy printed from the Digital Archive of the Hamilton County Surveyor's Office; One Hamilton Co. Square, Ste. 188, Noblesville, In 46060

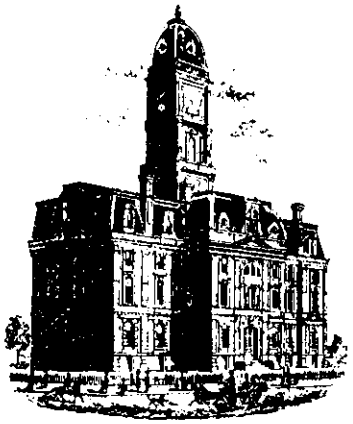

SURVEYOR'S OFFICE

Hamilton County

Kenton C. Ward, Surveyor
Phone (317) 776-8495
Fax (317) 776-9628

Suite 146
One Hamilton County Square
Noblesville, Indiana 46060-2230

To: Hamilton County Drainage Board

September 3, 1997

Re: **Crooked Creek Drain - Villages @ Weston Place Sec. 2**

Attached are as-builts, certificate of completion & compliance, and other information for The Villages @ Weston Place Sec. 2. An inspection of the drainage facilities for this section has been made and the facilities were found to be complete and acceptable.

During construction, changes were made to the drain which will alter the plans submitted with my report for this drain dated June 15, 1996. The changes are as follows:
Str.913-914 12"RCP lengthened from 193' feet to 194' feet.
Str.903-904 30"RCP shortened from 189' feet to 187' feet.
Str.912-913 18"RCP shortened from 132' feet to 121' feet.
Str.913-915 15"RCP lengthened from 206' feet to 218' feet.
Inlet-897 18"RCP at 7.5' feet was additional structure installed during construction.
Str.897-896 27"RCP shortened from 140' feet to 139' feet.
Str.898-899 15'RCP shortened from 43' feet to 41' feet.
Str.909-908 was incorrectly reported as 172' feet of 15"RCP. This structure is 72' feet of 15"RCP.
Str.908-907 18"RCP shortened from 93' feet to 90' feet.
Str.904-911 24"RCP shortened from 294' feet to 292' feet.
The corrected total of 6"SSD is 5,258 feet.

The length of the drain due to the changes described above is now **7,782 feet**.

The non-enforcement was approved by the Board at its meeting on April 23, 1996 and recorded under instrument #9609634779.

This copy printed from the Digital Archive of the Hamilton County Surveyor's Office; One Hamilton Co. Square, Ste. 188, Noblesville, In 46060

The bond or letter of credit from Frontier Insurance Co, number 89106 for storm sewer and subsurface drain and 89107 for erosion control ; dated June 11, 1996; in the amount of $124,000.00 and $3,000.00; has been recommended for release in a letter to the Commissioners dated August 25, 1997.

I recommend the Board approve the drains construction as complete and acceptable.

Sincerely,

Kenton C. Ward,
Hamilton County Surveyor

KCW/slm

This copy printed from the Digital Archive of the Hamilton County Surveyor's Office; One Hamilton Co. Square, Ste. 188, Noblesville, In 46060

Asbuilt Structures

Project: Crooked Creek Drain - Villages @ Weston Place - Sec 2

Structure:	T.C.:	I.E.:	Pipe:	Length:	Original Plans:	Difference:
913	898.70	896.72				
914	—	897.28	12"	194'	From 153'	
898	902.48	894.04				
901	898.71	894.44	33"	116'		
901	898.71	894.44				
903	898.70	894.87	30"	211'		
903	898.70	894.87				
904	899.19	895.44	30"	187'	From 189'	
911	899.60	896.28				
912	899.75	896.37	24"	31'		
912	899.75	896.37				
913	898.70	896.72	18"	121'	From 132'	
913	898.70	896.72				
915	—	897.36	15"	218'	From 206'	
INLET	—	896.49				
897	897.84	894.69	18"	7.5	additional Structure	
897	897.84	894.69				
896	898.92	894.27	27"	139'	From 140'	

6" SSD Streets:

Total: _____

6" SSD Lots:

Total: _____

RCP Pipe Totals:

Other Drain:	

Total Length of Drain: _____

This copy printed from the Digital Archive of the Hamilton County Surveyor's Office; One Hamilton Co. Square, Ste. 188, Noblesville, In 46060

Asbuilt Structures

Project: Crooked Creek Drain - Villages @ Weston Place - Sec 2

Structure:	T.C.:	I.E.:	Pipe:	Length:	Original Plans:	Difference:
896	898.92	894.87				
895	898.89	894.17	30"	30'		
895	898.89	894.17				
Ext	897.57	893.30	36"	291'		
Ext	897.57	893.30				
898	900.48	894.04	33"	176'		
898	900.48	894.50				
899	898.69	895.06	15"	41'	FRM 43'	
899	898.69	895.06				
900	898.70	895.31	12"	30'		
902	898.47	894.84				
901	898.71	894.66	12"	30'		
909	899.0	896.67				
908	899.58	896.46	15"	72'	Incorrectly Reported as 172'	
908	899.58	896.46				
907	899.54	896.19	18"	90'	FRM 93'	
907	899.54	896.19				
906	899.43	896.10	24"	31'		

6" SSD Streets:

Total: _____

6" SSD Lots:

Total: _____

RCP Pipe Totals:

Other Drain:	

Total Length of Drain: _____

This copy printed from the Digital Archive of the Hamilton County Surveyor's Office; One Hamilton Co. Square, Ste. 188, Noblesville, In 46060

PAGE 3

Asbuilt Structures

Project: Crooked Creek Drain - Villages @ Weston Place Sec 2

Structure:	T.C.:	I.E.:	Pipe:	Length:	Original Plans:	Difference:
906	899.43	896.10				
905	899.38	895.93	24"	56'		
905	899.38	895.93				
904	899.19	895.15	27"	160'		
904	899.19	895.44				
911	899.60	896.28	24"	292	FAN 294'	

6" SSD Streets:

Bunker Hill	428.59
Construction	1935.72
Const. Cul de Sac	265

6" SSD Lots:

Total: 2629.31 X 2 = 5258.62 **Total:**

RCP Pipe Totals:

12"	254'	Okay
15"	331'	Okay
18"	218.50	Okay
24"	410'	Okay
27"	299'	
30"	428'	
33"	292'	
36"	291'	

= 2523.5

Other Drain:	

Total Length of Drain: ± 7782'

This copy printed from the Digital Archive of the Hamilton County Surveyor's Office; One Hamilton Co. Square, Ste. 188, Noblesville, In 46060

THE VILLAGE @ WESTON PLACE
SECTION TWO

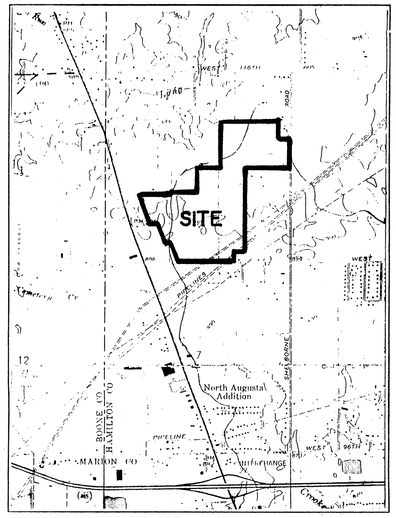

LOCATION MAP

Developed by:
ESTRIDGE DEVELOPMENT COMPANY, INC.
1041 WEST MAIN STREET
CARMEL, INDIANA 46032
(317)-582-2437

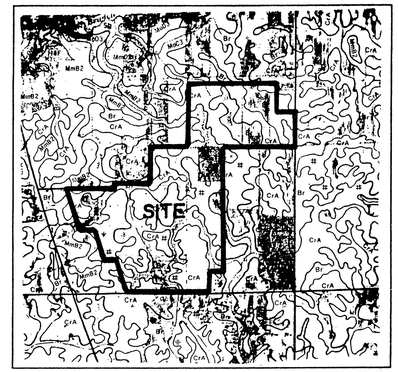

SOILS MAP

MmB2	MIAMI
Br	BROOKSTON
CrA	CROSBY

N.O.I. LETTER OPERATOR:
KEN BRASSEUR
ESTRIDGE DEVELOPMENT COMPANY, INC.
1041 WEST MAIN STREET
PHONE: (317)-582-2437

INDEX

SHT.	DESCRIPTION
1	COVER SHEET
2	SITE DEVELOPMENT PLAN
3	EROSION CONTROL PLAN
4	STREET PLAN & PROFILE
5	STREET PLAN & PROFILE
5A	TRAFFIC CONTROL PLAN
6	INTERSECTION DETAILS
7	SANITARY SEWER PLAN & PROFILES
8	SANITARY SEWER PLAN & PROFILES
9	STORM SEWER PLAN & PROFILES
10	STORM SEWER PLAN & PROFILES
11	CONSTRUCTION DETAILS
12	CONSTRUCTION DETAILS
13	CONSTRUCTION DETAILS

REVISIONS

SHT.	DESCRIPTION
ALL	REV. PER T.A.C. COMMENTS 12/28/95 EEF
5A	ADD TRAFFIC CONTROL PLAN 1/16/96 EEF

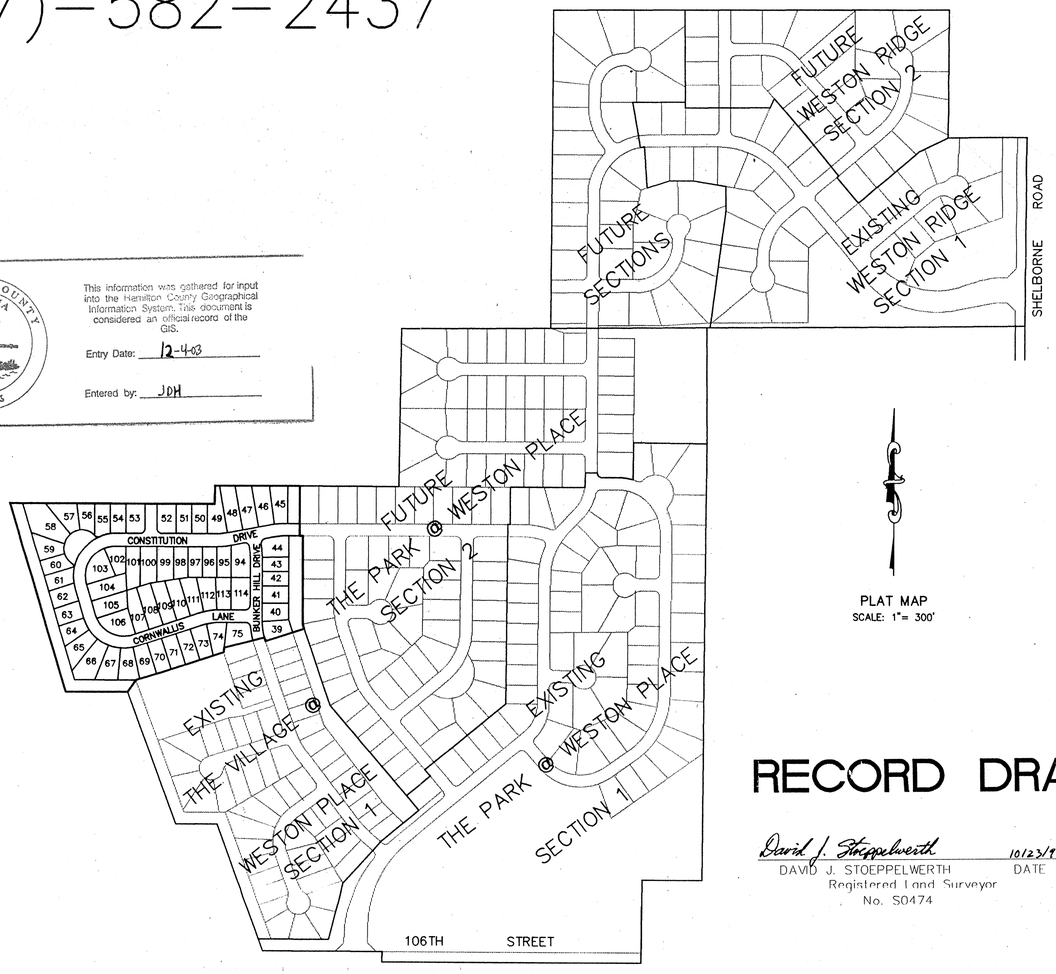

PLAT MAP
SCALE: 1"= 300'

DESIGN DATA

58 LOTS / 17.521 AC. = 3.31 LOTS/ACRE

BUNKER HILL DRIVE	412.86 L.F.
CORNWALLIS LANE	1013.62 L.F.
CONSTITUTION DRIVE	907.10 L.F.
MONITOR LANE	130.00 L.F.

HAMILTON COUNTY INDIANA 1823

This information was gathered for input into the Hamilton County Geographical Information System. This document is considered an official record of the GIS.

Entry Date: 12-4-03

Entered by: JDH

PLANS PREPARED BY:

STOEPPELWERTH & ASSOCIATES, INC.
CONSULTING ENGINEERS & LAND SURVEYORS
9940 ALLISONVILLE ROAD
P.O. BOX 509007
INDIANAPOLIS, INDIANA 46250
PHONE: (317)-849-5935
FAX: (317)-849-5942

RECORD DRAWING

David J. Stoeppelwerth 10/23/96
DAVID J. STOEPPELWERTH DATE
Registered Land Surveyor
No. S0474

DAVID J. STOEPPELWERTH REGISTERED No. S0474 STATE OF INDIANA LAND SURVEYOR

PLANS CERTIFIED BY:

David J. Stoeppelwerth 11/20/95
DAVID J. STOEPPELWERTH DATE
PROFESSIONAL ENGINEER
NO. 19358

DAVID J. STOEPPELWERTH REGISTERED No. 19358 STATE OF INDIANA PROFESSIONAL ENGINEER

FILED
OCT 25 1996
HAMILTON COUNTY SURVEYOR

This copy printed from the Digital Archive of the Hamilton County Surveyor's Office; One Hamilton Co. Square, Ste. 188, Noblesville, In 46060

F:\DWG\P\19584V\SCOVER Tue Jan 16 13:50:36 1996 EEF

"HOLEY MOLEY" SAYS:

1-800-382-5544
CALL TOLL FREE

1-800-428-5200
FOR CALLS OUTSIDE OF INDIANA

CAUTION

LOCATION OF ALL EXISTING UNDERGROUND UTILITIES SHOWN ON THIS PLAN ARE BASED UPON ABOVE GROUND EVIDENCE, (including, but not limited to, manholes, inlets, valves, & marks made upon the ground by others.) AND ARE SPECULATIVE IN NATURE. THERE MAY ALSO BE OTHER EXISTING UNDERGROUND UTILITIES FOR WHICH THERE IS NO ABOVE GROUND EVIDENCE OR FOR WHICH NO ABOVE GROUND EVIDENCE WAS OBSERVED. THE EXACT LOCATIONS OF SAID EXISTING UNDERGROUND UTILITIES SHOULD BE VERIFIED BY THE CONTRACTOR PRIOR TO ANY AND ALL CONSTRUCTION.

LEGEND

- 848 — EXISTING CONTOUR
- EXISTING SANITARY SEWER
- EXISTING STORM SEWER
- 848.0 PROPOSED GRADE
- 848 PROPOSED CONTOUR
- PROPOSED SANITARY SEWER
- PROPOSED STORM SEWER
- PROPOSED SWALE
- PROPOSED 4' SIDEWALK (BY HOME BUILDER)
- 35 / 853.0 ☆ LOT NUMBER; PAD ELEVATION; PAD SIZE 50'x65'; DENOTES PADS OF 2'-0" OF FILL OR MORE
- PROPOSED 6" UNDERDRAINS

BENCHMARK:
U.S.G.S. S-78
STANDARD TABLET SET IN CONCRETE APPROX.
1000' NORTH OF 106th STREET @ EAST R/W LINE
OF US #421. ELEV.=900.77

S.&A NO. 3
P.K. NAIL IN NORTH FACE OF PWP #12-128A
12" UP POLE IS 33' WEST OF PANHANDLE
EASTERN RED & WHITE GAS LINE MARKER
ELEV.= 895.04

RECORD DRAWING

David J. Stoeppelwerth 10/21/96
DAVID J. STOEPPELWERTH DATE
Registered Land Surveyor
No. S0474

DAVID J. STOEPPELWERTH REGISTERED No. S0474 STATE OF INDIANA LAND SURVEYOR

NOTE:
ALL PADS PLACED SHALL BE COMPACTED TO 95% OF MAX. DENSITY USING THE STANDARD PROCTOR TEST METHOD.

EACH PAD TO HAVE AT LEAST 1'-0" OF OVERBUILD IN FRONT OF THE BUILDING LINE.

ALL SIDEWALKS CONTINUED ACROSS AND IN CONJUNCTION WITH RESIDENTIAL DRIVEWAYS SHALL BE 6" THICK.

ALL FRONT YARDS SHALL BE AS FLAT AS POSSIBLE FROM THE BACK OF CURB TO APPROX. 5' IN FRONT OF THE BUILDING SETBACK LINE.

CONCRETE SLAB CONSTRUCTION ONLY.
NO SUBSURFACE DRAIN STUBS WILL BE REQUIRED IN THIS SECTION.

SCALE: 1"= 50'

DAVID J. STOEPPELWERTH REGISTERED No. 19358 STATE OF INDIANA PROFESSIONAL ENGINEER

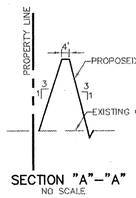

SECTION "A"-"A"
NO SCALE

STORM SEWER TABLE

Str. No.	Type	Tc/Rim	Inverts	Dir.	Inverts	Dir.
895	Curb Inlet	898.23	894.17	(N)(S)(SE)		
896	Curb Inlet	898.81	894.35	(N)(S)		
897	Yard Inlet	897.50	894.48	(S)		
898	Manhole	900.00	893.83	(N)(E)	894.83	(S)
899	Curb Inlet	898.70	894.96	(N)(S)		
900	Curb Inlet	898.70	895.05	(N)		
901	Curb Inlet w/Manhole	898.59	894.18	(S)(E)(W)		
902	Curb Inlet	898.59	894.27	(W)		
903	Yard Inlet	898.50	894.81	(E)(W)		
904	Yard Inlet	898.80	895.38	(E)(W)(N)		
905	Double Curb Inlet	899.32	895.86	(S)(N)		
906	Curb Inlet	899.23	896.03	(S)(W)		
907	Double Curb Inlet	899.23	896.48	(N)(E)		
908	Yard Inlet	899.70	896.48	(S)(E)		
909	Yard Inlet	899.00	896.62			
912	Double Curb Inlet	899.66	896.26	(E)(W)		
913	Curb Inlet	899.66	896.35	(E)(W)		
914	Concrete End Section	899.30	896.75	(E)(N)(S)		
915	Concrete End Section	——	897.33	(N)		
		——	897.37	(S)		
	19584AS2					

SEE RECORD DRAWING

SEE RECORD DRAWING

SEE RECORD DRAWING

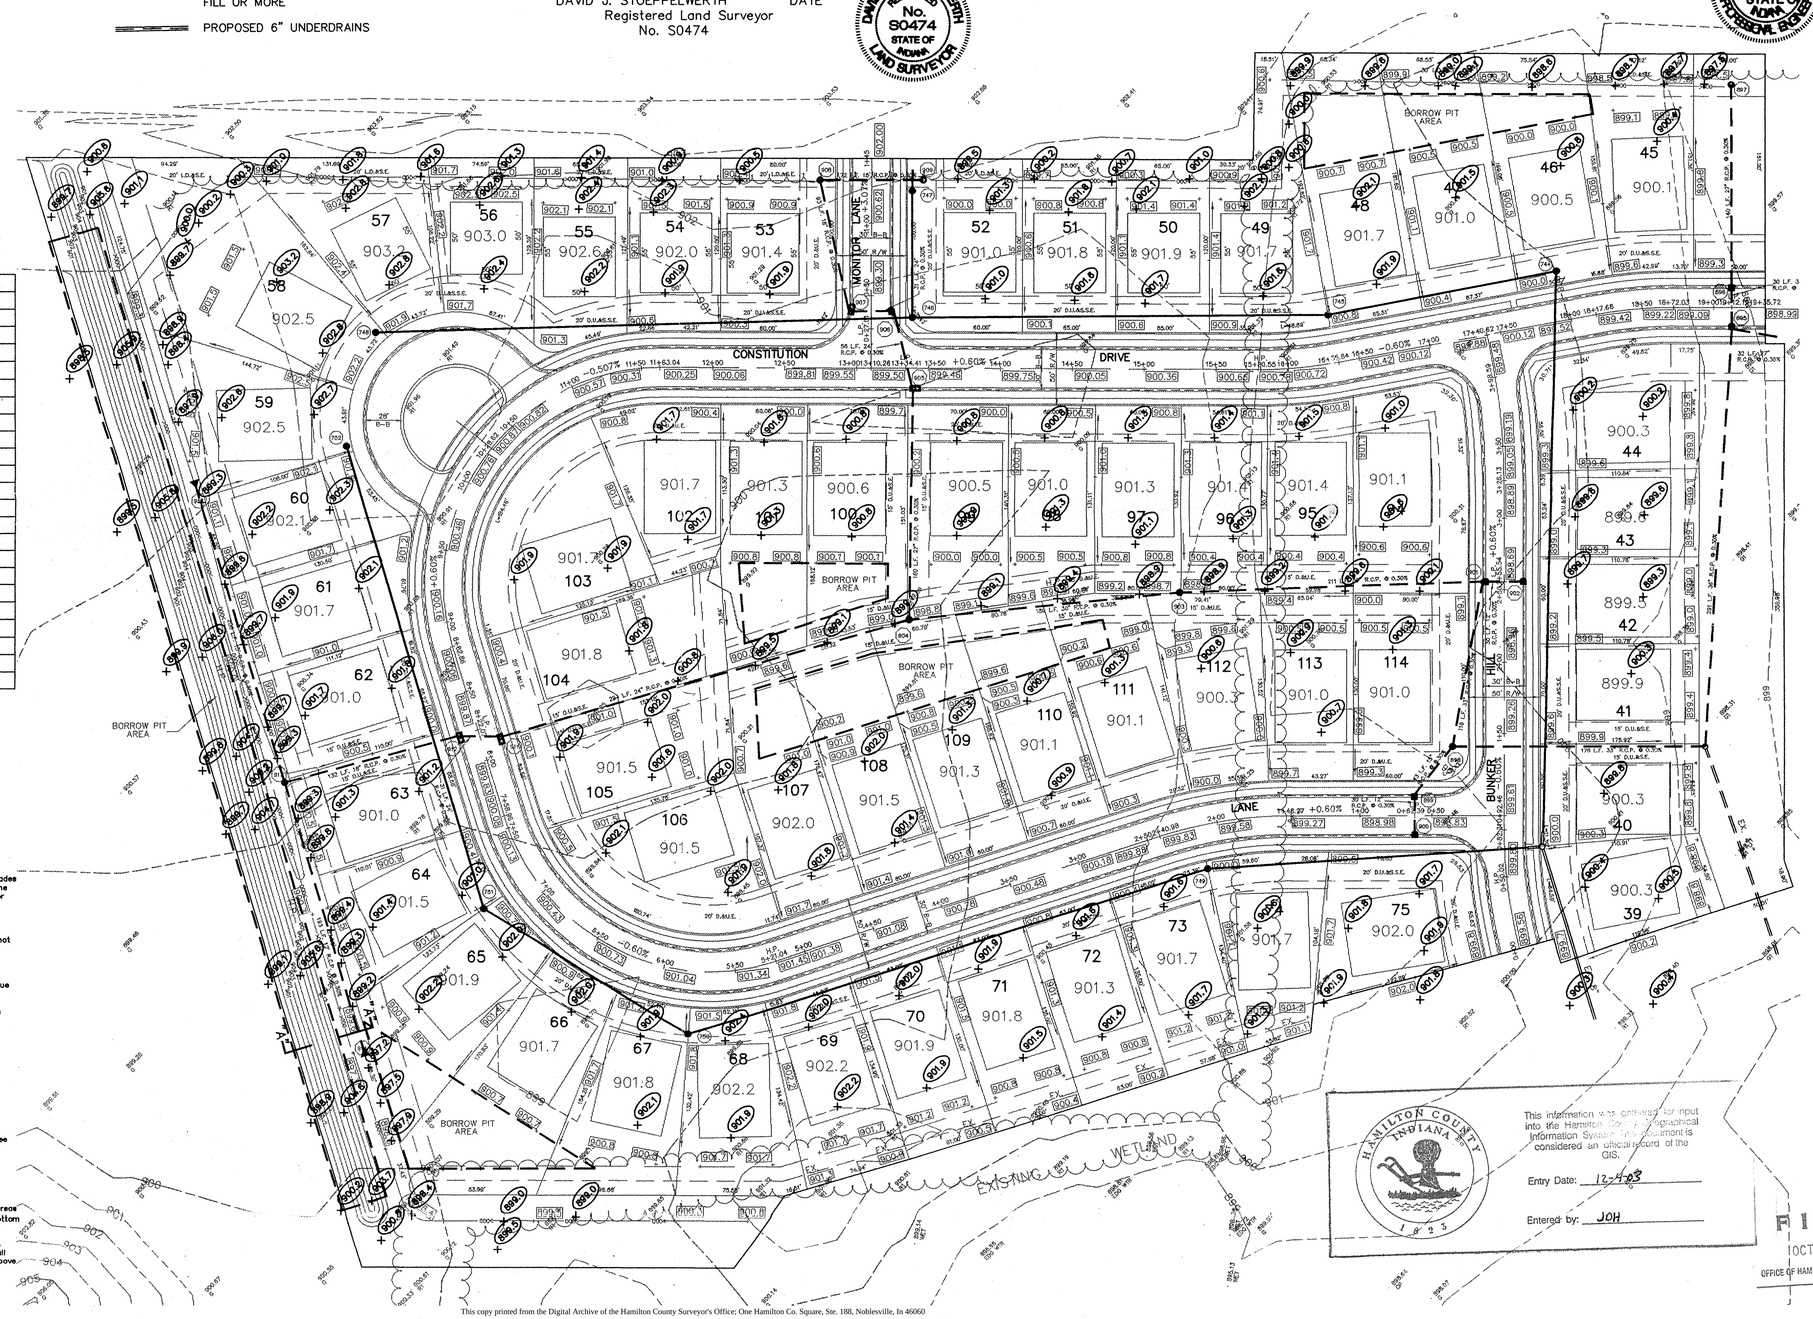

EARTHWORK:

1. EXCAVATION
   - A. Excavated material that is suitable may be used for fills. All unsuitable material and all surplus excavated material not required shall be removed from the site.
   - B. Provide and place any additional fill material from offsite as may be necessary to produce the grades required on plans. Fill obtained from offsite shall be of quality as specified for fills herein and the source approved by the Developer. It will be the responsibility of the Contractor for any costs for fill needed.
2. REMOVAL OF TREES
   - A. All trees and stumps from area to be occupied by a road surface area. Trees and stumps shall not be buried on site.
3. PROTECTION OF TREES
   - A. The Contractor shall, at the direction of the Developer, endeavor to save and protect trees of value and worth which do not impair construction of improvements as designed.
   - B. In the event cut or fill exceeds 0.5 foot over the root area, the Developer shall be consulted with respect of protective measure to be taken, if any, to preserve such trees.
4. REMOVAL OF TOPSOIL
   - A. Removal of topsoil to a depth of 6 inches (or more if required by Engineer) from all area to be excavated or filled. Topsoil should be stored at a location where it will not interfere with construction operations. The topsoil shall be free of debris and stones.
5. UTILITIES
   - A. Rules and regulation governing the respective utility shall be observed in executing all work under this section.
   - B. It shall be the responsibility of the Contractor to determine the location of existing underground utilities 2 working days prior to commencing work. For utility locations to be marked call Toll Free 1-800-382-5544 within Indiana or 1-800-428-5200 outside Indiana.
6. SITE GRADING
   - A. Do all cutting, filling, compacting of fills and rough grading required to bring entire project area to subgrade as shown on the drawing.
   - B. The tolerance for paved areas shall not exceed 0.10 feet above established subgrade. All other areas shall not exceed 0.10 feet plus or minus the established grade. Provide roundings at top and bottom of banks and other breaks in grade.
   - C. The Engineer shall be notified when the Contractor has reached the tolerance as stated above, so that field measurements and spot elevations can be verified by the Engineer. The Contractor shall not remove his equipment from the site until the Engineer has verified that the job meets the above tolerance.

FORM\EARTHWRK

This copy printed from the Digital Archive of the Hamilton County Surveyor's Office; One Hamilton Co. Square, Ste. 188, Noblesville, In 46060

HAMILTON COUNTY INDIANA 1823

This information was retrieved for input into the Hamilton County Geographical Information System. This document is considered an official record of the GIS.

Entry Date: 12-4-03

Entered by: JOH

FILED
10CT 25 1996
OFFICE OF HAMILTON COUNTY SURVEYOR

BY	REVISIONS	DATE	MARK
TLT	ASBUILTS	10/21/96	
SCS	ADJUST PADS & REAR YARDS TO BALANCE DIRT	2/22/96	
EEF	REV. PER SURVEYORS COMMENTS	1/10/96	
EEF	REV. PER HIGHWAY COMMENTS	1/5/96	
EEF	REV. PER DEVELOPER CHANGES & T.A.C. COMMENTS	12/26/95	

DRWN. BY WAB
CK. BY WAB
SCALE 1"=50'
DATE 11/20/95

CERTIFIED: 11/20/95
David J. Stoeppelwerth

CONSULTING ENGINEERS - LAND SURVEYORS
(317) 849-5935 1-800-728-6917 FAX: (317) 849-5942
INDIANAPOLIS INDIANA

SITE DEVELOPMENT PLAN
THE VILLAGE @ WESTON PLACE
SECTION TWO
CARMEL INDIANA

SHEET NO. 2
OF 13 SHEETS
JOB NO. 19584A

F:\DWG\P\19584\S2-GRADE Thu Oct 24 09:39:22 1996 TLT

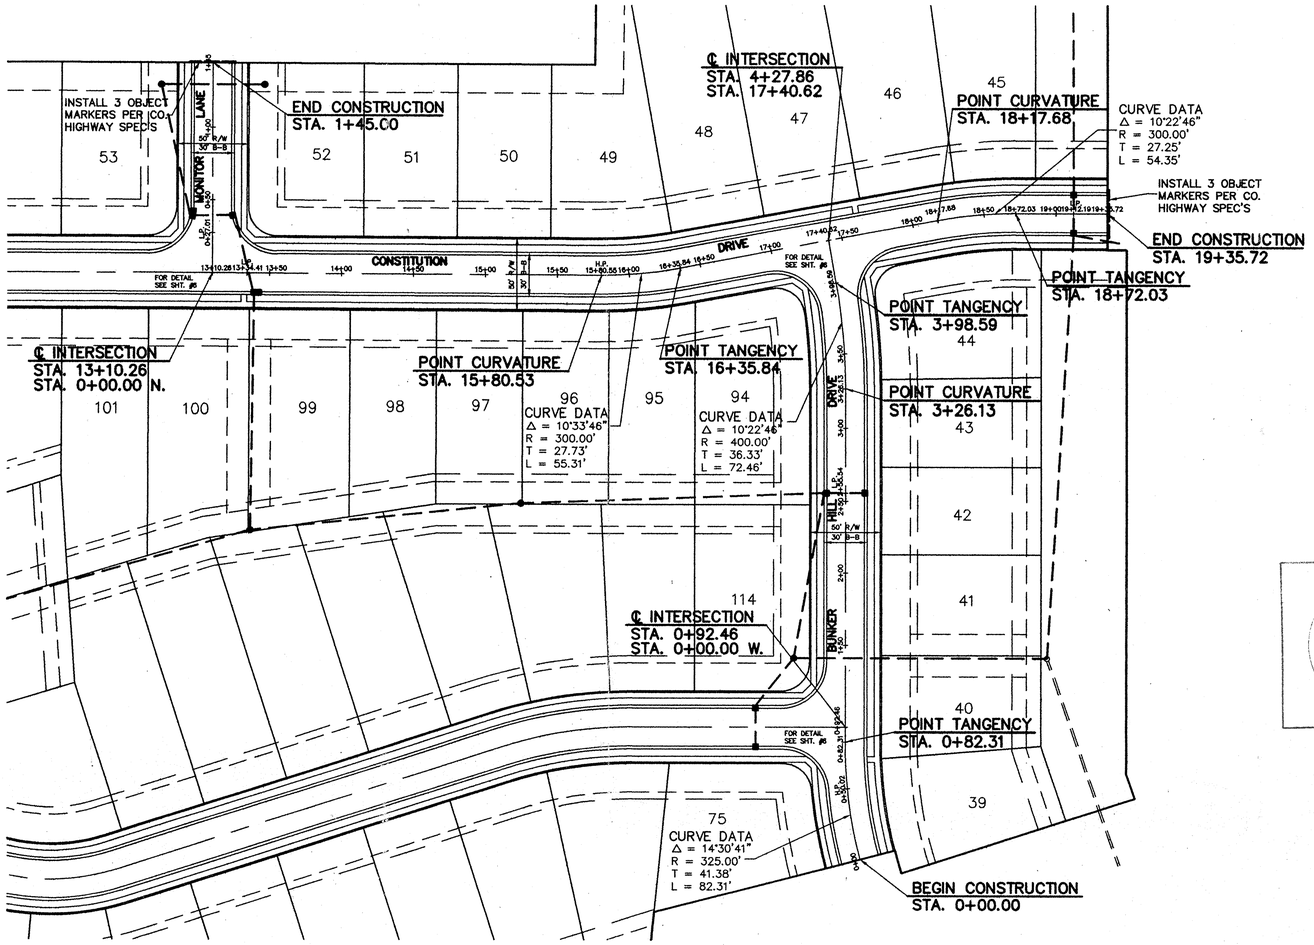

SCALE: 1"= 50'

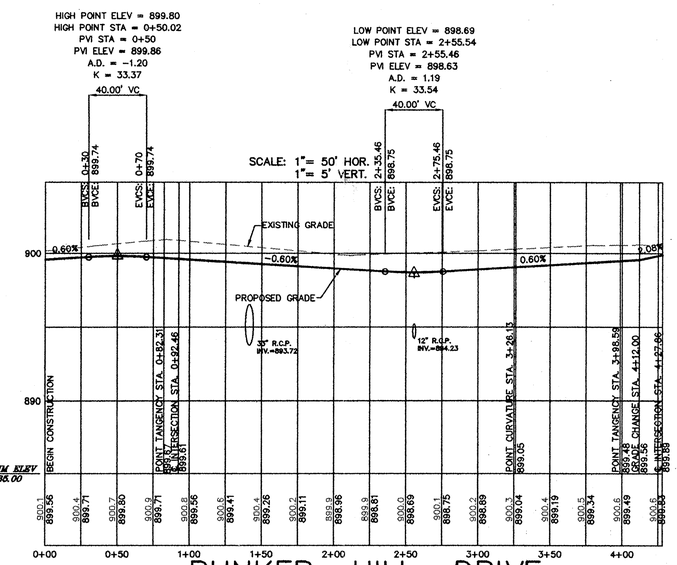

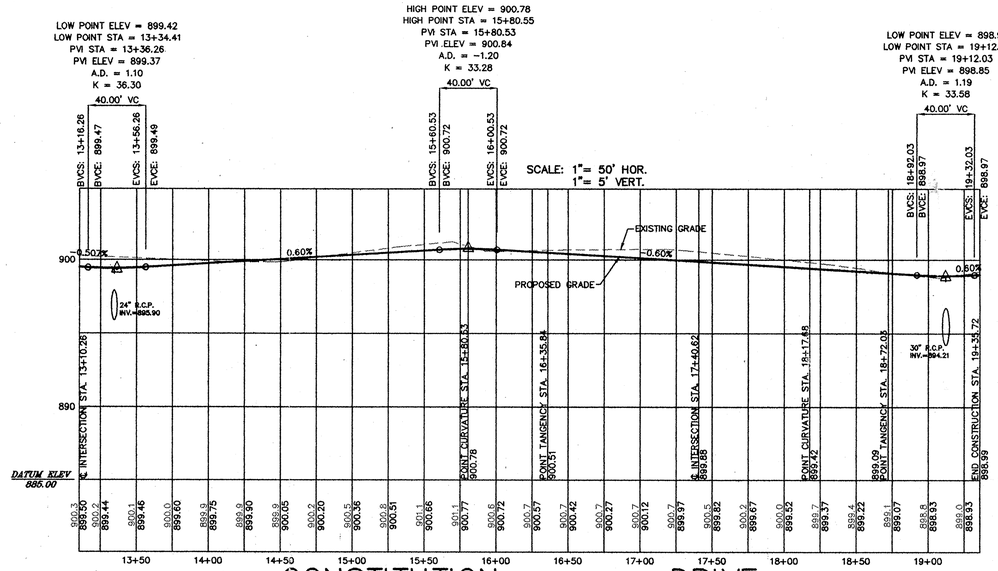

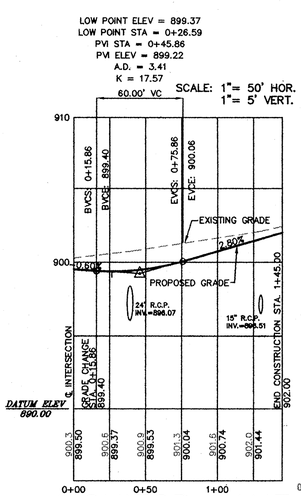

HAMILTON COUNTY INDIANA 1823

This information was gathered for input into the Hamilton County Geographical Information System. This document is considered an official record of the GIS.

Entry Date: _____

Entered by: _____

FILED
JUN 06 1996
OFFICE OF HAMILTON COUNTY SURVEYOR

DAVID J. STOEPPELWERTH
REGISTERED
No. 19358
STATE OF INDIANA
PROFESSIONAL ENGINEER

CERTIFIED: 11/20/95

David J. Stoeppelwerth

DWN. BY	CK. BY	SCALE	DATE	MARK	REVISIONS	BY
EEF	WAB	1"=50'	09/20/96		REV. MONITOR LANE STREET PROFILE	LMC
			11/20/95			

STOEPPELWERTH & ASSOCIATES, INC.
CONSULTING ENGINEERS – LAND SURVEYORS
(317) 849-5935 1-800-728-6917 FAX:(317) 849-5942
INDIANAPOLIS INDIANA

STREET PLAN & PROFILE
THE VILLAGE @ WESTON PLACE
SECTION TWO

CARMEL INDIANA

SHEET NO. 4 OF 13 SHEETS

JOB NO. 19584 A

This copy printed from the Digital Archive of the Hamilton County Surveyor's Office; One Hamilton Co. Square, Ste. 188, Noblesville, In 46060

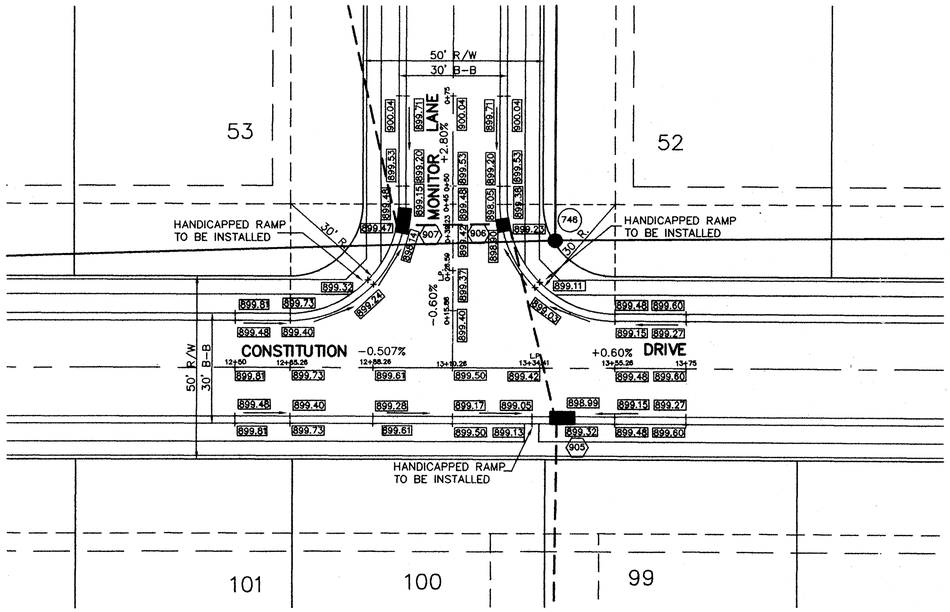

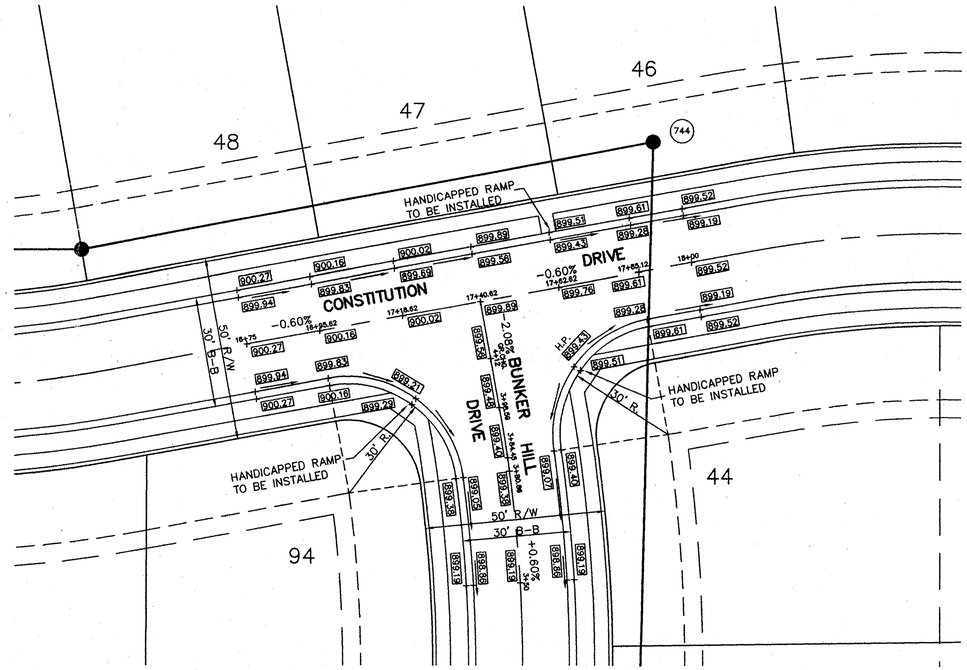

SCALE: 1" = 20'

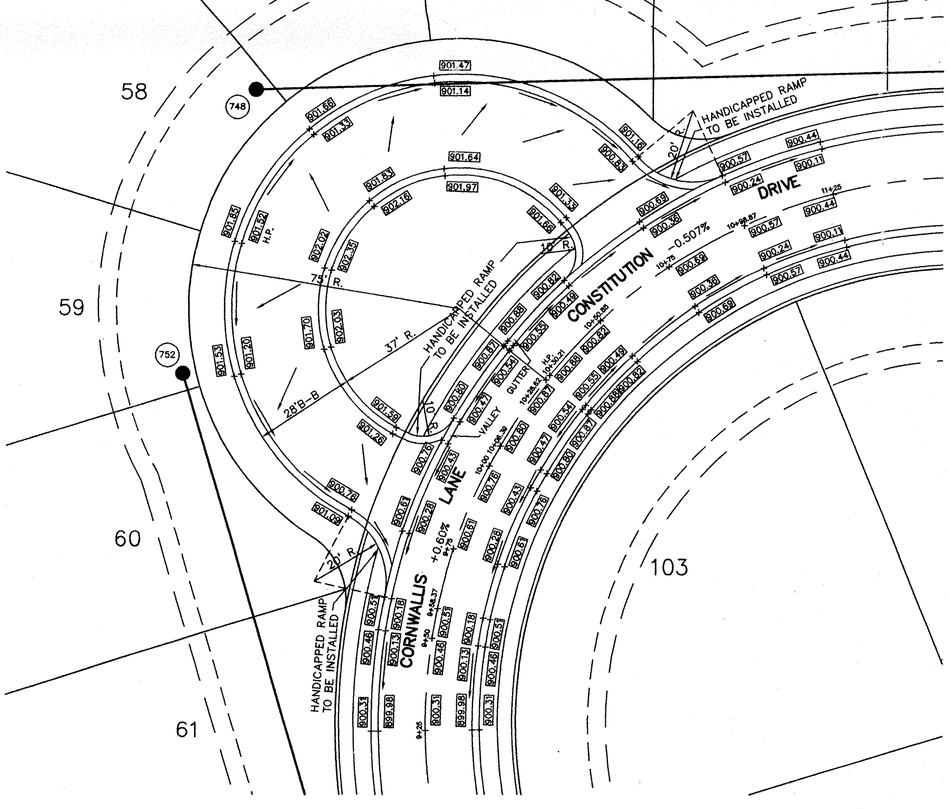

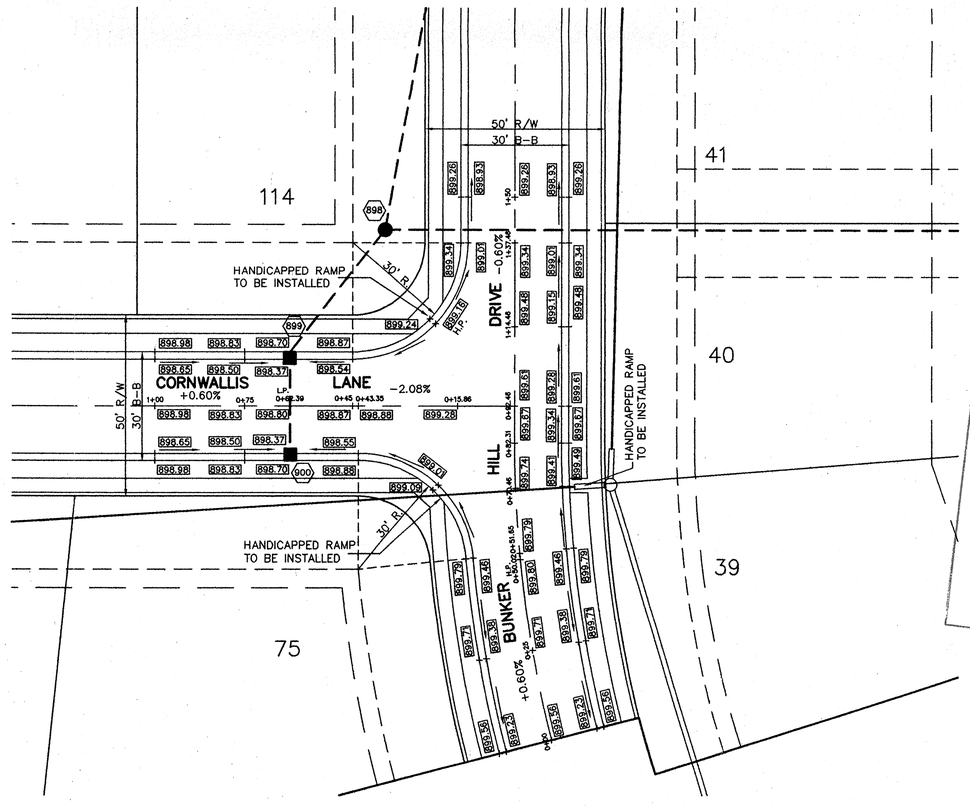

This information was gathered for input into the Hamilton County Geographical Information System. It is not to be considered an official record of the GIS.

Entry Date: _____

Entered by: _____

HAMILTON COUNTY INDIANA

FILED

JUN 06 1996

OFFICE OF HAMILTON COUNTY SURVEYOR

DAVID J. STOEPPELWERTH REGISTERED No. 19358 STATE OF INDIANA PROFESSIONAL ENGINEER

BY	REVISIONS	DATE	MARK
LMC	REV. INTL. DTL. @ CONSTITUTION DR. & MONITOR LANE	06/03/96	
EEF	REV. PER HIGHWAY COMMENTS	1/5/96	
	REV. PER T.A.C. COMMENTS	12/28/95	

DWN. BY: EEF
CK. BY: WAB
SCALE: 1" = 20'
DATE: 11/20/95

CERTIFIED: 11/20/95

David J. Stoeppelwerth

CONSULTING ENGINEERS – LAND SURVEYORS
(317) 849-5935 1-800-728-6917 FAX:(317) 849-5942
INDIANAPOLIS

INTERSECTION DETAILS
THE VILLAGE @ WESTON PLACE SECTION TWO

CARMEL INDIANA

SHEET NO. 8 OF 13 SHEETS

JOB NO. 19584

This copy printed from the Digital Archive of the Hamilton County Surveyor's Office; One Hamilton Co. Square, Ste. 188, Noblesville, In 46060

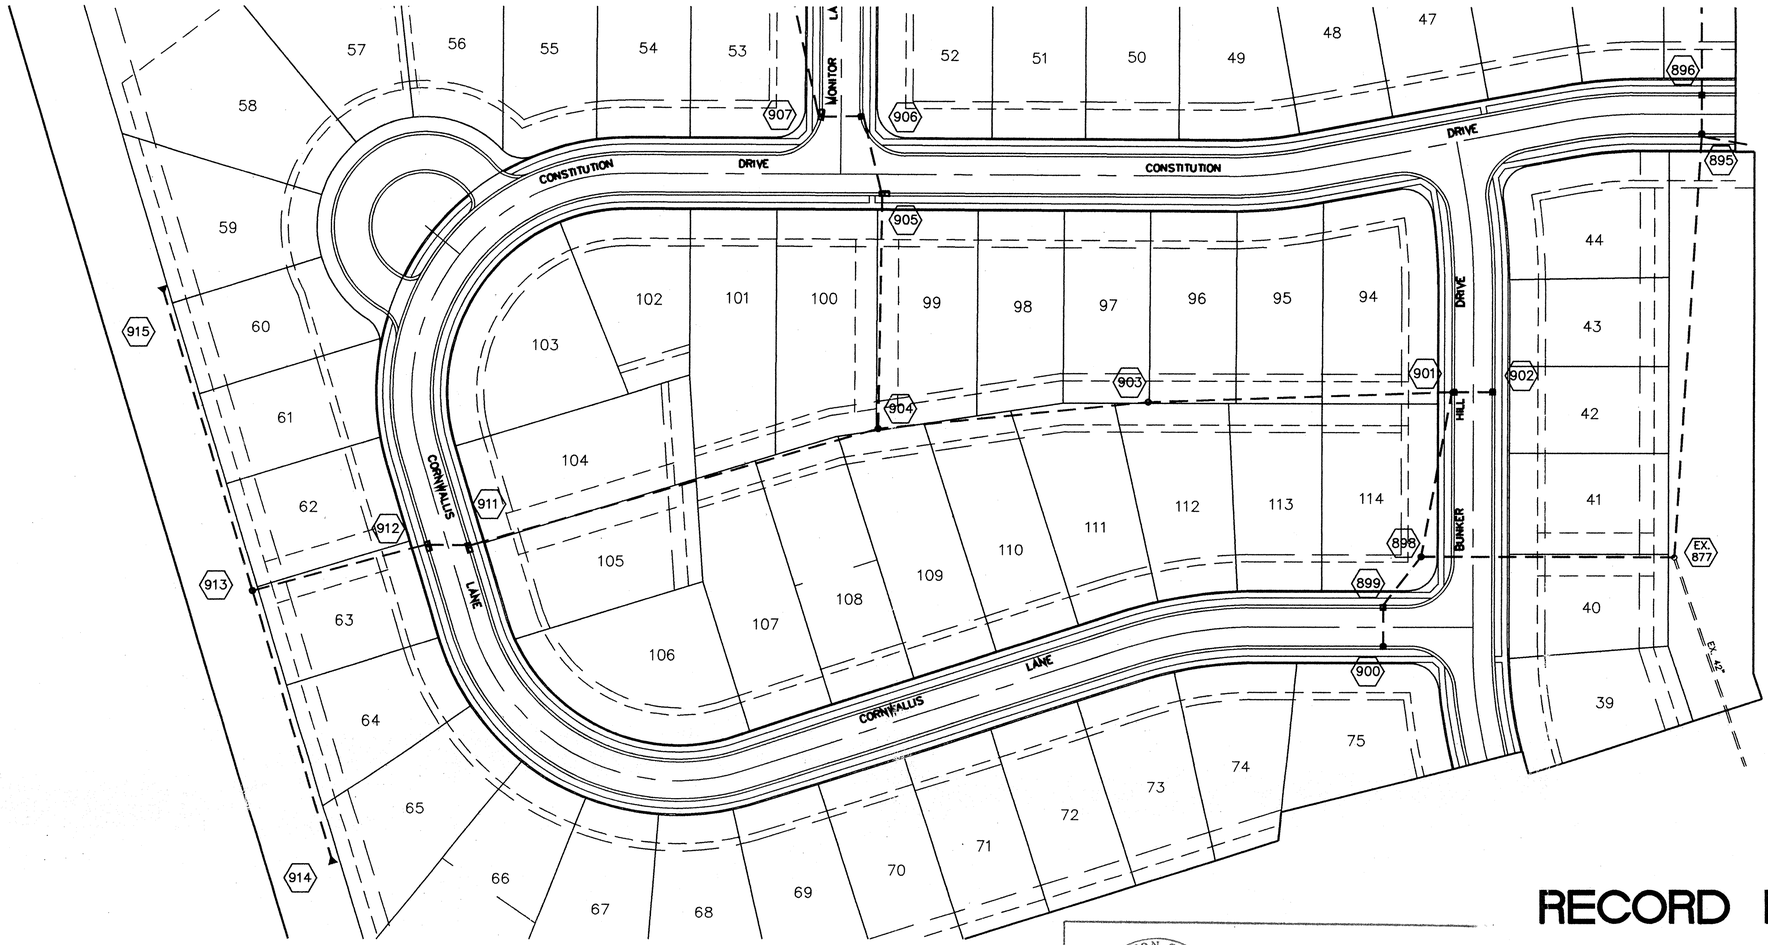

SCALE: 1"= 50'

DAVID J. STOEPPELWERTH REGISTERED No. 19358 STATE OF INDIANA PROFESSIONAL ENGINEER

BY	REVISIONS	DATE	MARK
TLT	REV. UTILITIES	10/03/96	
EEF	REV. PER DEVELOPER COMMENTS	12/7/95	

DRW. BY: EEF
CK. BY: WAB
SCALE: 1"=50'
DATE: 11/20/95

CERTIFIED: 11/20/95

David J. Stoeppelwerth

CONSULTING ENGINEERS – LAND SURVEYORS
(317) 849-5935 1-800-728-6917 FAX:(317) 849-5942
INDIANAPOLIS INDIANA

STOEPPELWERTH & SAINT

STORM SEWER PLAN & PROFILE
THE VILLAGE @ WESTON PLACE
SECTION TWO

CARMEL INDIANA

SHEET NO. 9 OF 13 SHEETS

JOB NO. 19584 A

RECORD DRAWING

David J. Stoeppelwerth 10/23/96
DAVID J. STOEPPELWERTH DATE
Registered Land Surveyor
No. S0474

DAVID J. STOEPPELWERTH REGISTERED No. S0474 STATE OF INDIANA LAND SURVEYOR

HAMILTON COUNTY INDIANA 1823

This information was gathered for input into the Hamilton County Geographical Information System. This document is considered an official record of the GIS.

Entry Date: 12-4-03

Entered by: JOH

SCALE: 1"= 50' HOR.
1"= 5' VERT.

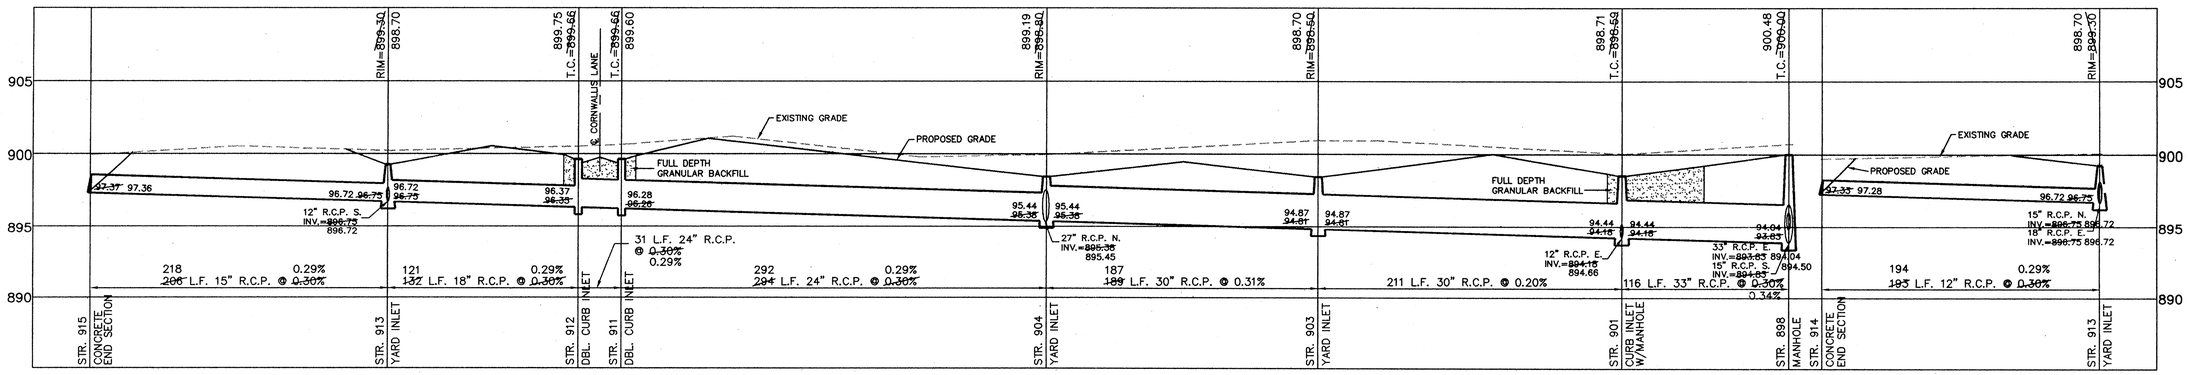

FILED
OCT 25 1996
OFFICE OF HAMILTON COUNTY SURVEYOR

This copy printed from the Digital Archive of the Hamilton County Surveyor's Office; One Hamilton Co. Square, Ste. 188, Noblesville, In 46060

F:\DWG\P\19584Y\SESTGRM1 Wed Oct 23 14:17:28 1996 TLT

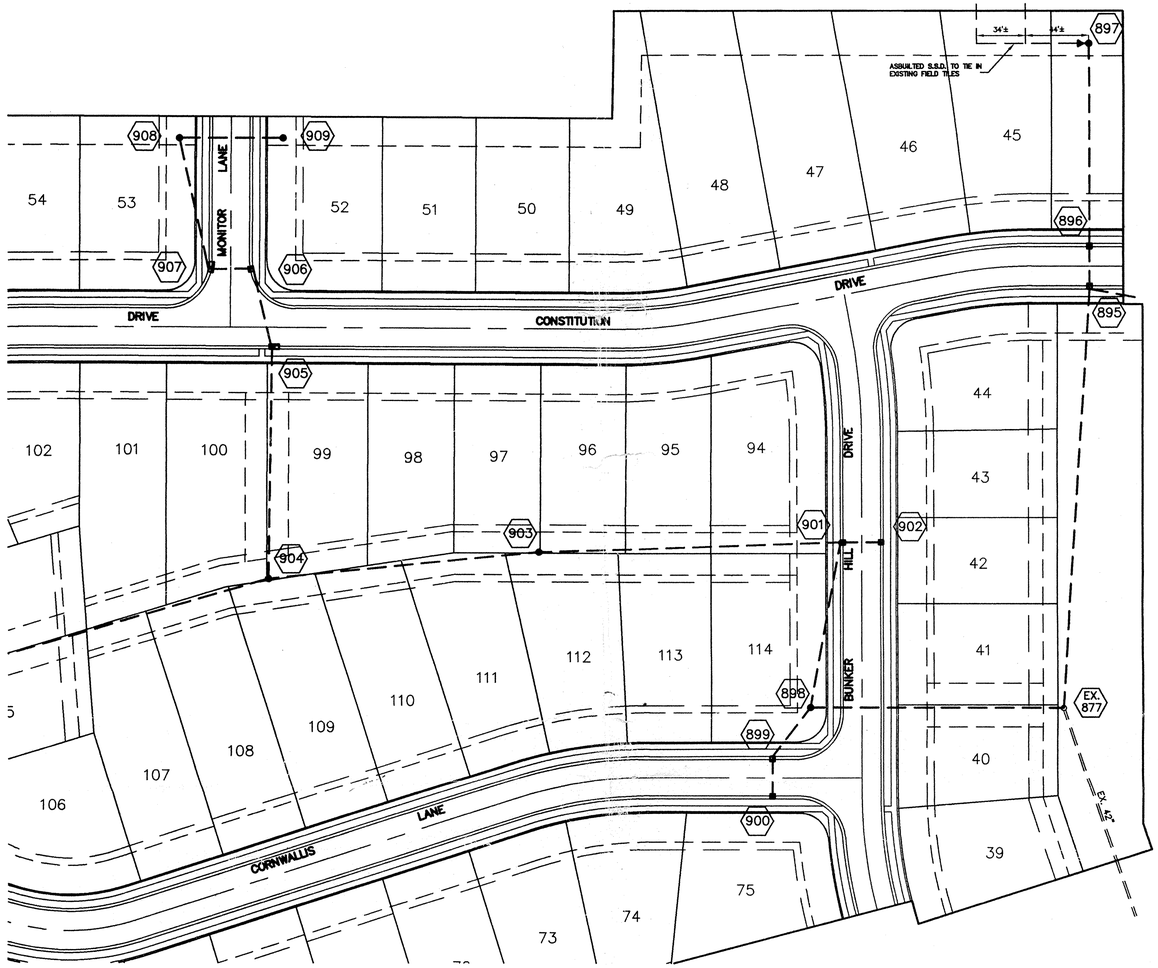

SCALE: 1"= 50'

RECORD DRAWING

David J. Stoeppelwerth 8/20/97

DAVID J. STOEPPELWERTH — DATE

Registered Land Surveyor
No. S0474

DAVID J. STOEPPELWERTH REGISTERED No. S0474 STATE OF INDIANA LAND SURVEYOR

This information was gathered for input into the Hamilton County Geographical Information System. This document is considered an official record of the GIS.

Entry Date: 12-4-03

Entered by: JDH

SCALE: 1"= 50' HOR.
1"= 5' VERT.

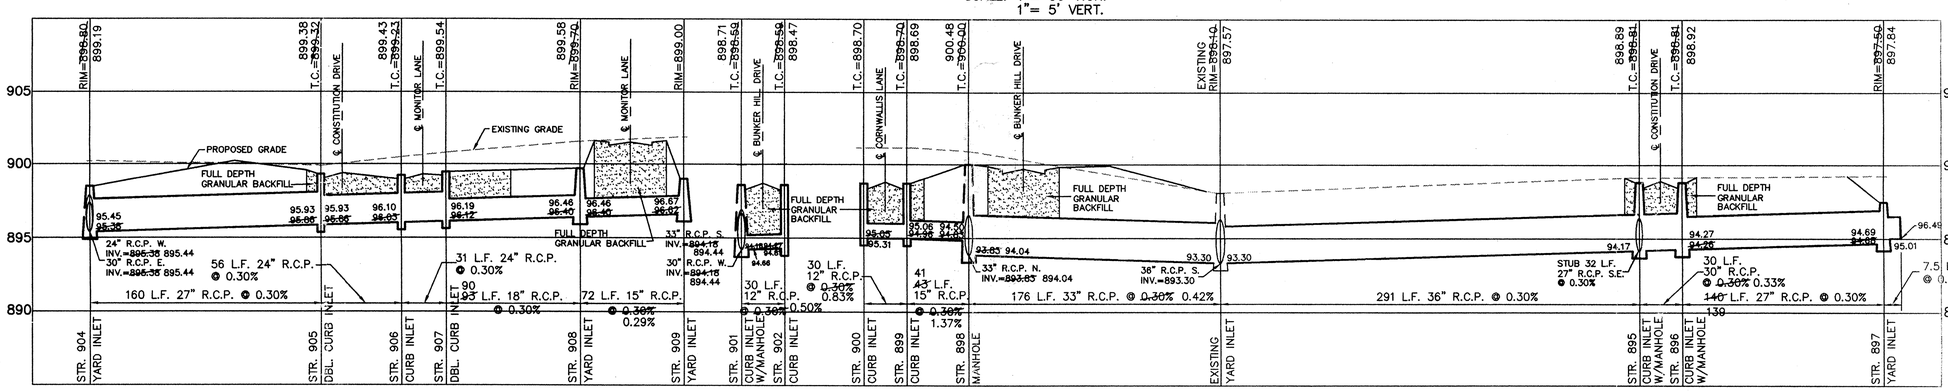

FILED
AUG 25 1997
OFFICE OF HAMILTON COUNTY SURVEYOR

This copy printed from the Digital Archive of the Hamilton County Surveyor's Office; One Hamilton Co. Square, Ste. 188, Noblesville, In 46060

DWN. BY	DATE	MARK	REVISIONS	BY
EEF	11/20/95			
CK. BY	7/22/97		REV. ASBUILTS	TLT
WAB	10/23/96		ASBUILTS	TLT
SCALE 1"=50'	06/20/96		REV. T.C. OF STORM STR. 908 & 907	LMC

CERTIFIED: 11/20/95

David J. Stoeppelwerth

ENGINEERS – LAND SURVEYORS
CONSULTING ENGINEERS & LAND SURVEYORS
1-800-728-6917 FAX:(317) 849-5942
(317) 849-5935 1-800-
INDIANAPOLIS
INDIANA

STORM SEWER PLAN & PROFILE
THE VILLAGE @ WESTON PLACE
SECTION TWO
CARMEL INDIANA

SHEET NO. 10 13 SHEETS

JOB NO. 19584 A

F:\DWG\P\19584V\SSSTORM2 Wed Aug 20 12:35:26 1997 TLT