Drain: DEERWALK ESTATES DRAIN **Drain #:** 236
Improvement/Arm: DEERWALK ESTATES - SECTION 1
Operator: JDH **Date:** 12-11-03
Drain Classification: **Urban**/Rural **Year Installed:** 1990

GIS Drain Input Checklist

- Pull Source Documents for Scanning — JH 12-11
- Digitize & Attribute Tile Drains — N/A
- Digitize & Attribute Storm Drains — JH 12-11
- Digitize & Attribute SSD — JH 12-11
- Digitize & Attribute Open Ditch —
- Stamp Plans — JH 12-11
- Sum drain lengths & Validate — JH 12-11
- Enter Improvements into Posse — JH 12-11
- Enter Drain Age into Posse — Done ✓
- Sum drain length for Watershed in Posse — Done ✓
- Check Database entries for errors — JH 12-11

This copy printed from the Digital Archive of the Hamilton County Surveyor's Office; One Hamilton Co. Square, Ste. 188, Noblesville, In 46060

Gasb 34 Footages for Historical Cost
Drain Length Log

Drain-Improvement: DEERWALK ESTATES DRAIN - DEERWALK ESTATES - SECTION 1

Drain Type:	Size:	Length (SURVEYORS REPORT)	Length (DB Query)	Length Reconcile	In Applicable Price:	In Applicable Cost:
SSD	6"	540'	540'	∅		
RCP	12"	393'	393'	∅		
	15"	150'	150'	∅		
CMP	48"	85'	85'	∅		
	142"x91"	96'	96'	∅		
OPEN DITCH		2,310'	2,310'	∅		
Sum:		3,589'	3,589'	∅		

Final Report:_____

Comments:

This copy printed from the Digital Archive of the Hamilton County Surveyor's Office; One Hamilton Co. Square, Ste. 188, Noblesville, In 46060

SURVEYOR'S OFFICE

Hamilton County

Kenton C. Ward, Surveyor

776-9626

942 Maple Avenue
Noblesville, Indiana 46060

June 13, 1990

TO: Hamilton County Drainage Board

RE: Deerwalk Estates Drain

Attached is a petition, non-enforcement request, plans, calculations, quanity summary and assessment roll for the Deerwalk Estates Drain.

I have reviewed the submittals and petition and have found each to be in proper form.

I have made a personal inspection of the land described in the petition. Upon doing so, I believe that the drain is practicable; will improve the public health; benefit a public highway and be of public utility; and that the costs, damages and expenses of the proposed drain will probably be less than the benefits accruing to the owners of land likely to be benefitted. The drain will consist of the following:

Open Ditch	2310 ft.	48" CMP	70 ft.
6" SSD	555 ft	142"x 91"	96 ft.
12" RCP	412 ft.		

The total length of the drain will be 3,441 feet.

The portions of the open ditch which is included in the above lengths are those located through Lots 19 and 20; between Lots 10, 11 and 9, 12 and that through and between Lots 5,4,3,2 and 1.

I have reviewed the plans and believe the drain will benefit each lot equally. Therefore, I recommend each lot be assessed equally. I recommend a maintenance assessment of $45.00 per lot or block, $5.00 per acre for roadways. With this assessment the total annual assessment for the

This copy printed from the Digital Archive of the Hamilton County Surveyor's Office; One Hamilton Co. Square, Ste. 188, Noblesville, In 46060

drain/this section will be $1025.00. Maintenance of Duck Creek is not included in the drain. Also, the ravine along the North side of Lots 12, 13 and 14 is not to be included as part of this drain.

I recommend a hearing be set for August 1990. Further, I recommend the Board approve the non-enforcement of the easement at that time if the drainage is approved.

Kenton C. Ward
Hamilton County Surveyor

KCW/no

This copy printed from the Digital Archive of the Hamilton County Surveyor's Office; One Hamilton Co. Square, Ste. 188, Noblesville, In 46060

WESTCHESTER FIRE INSURANCE COMPANY
518 Stuyvesant Avenue
P.O. Box 615
Lyndhurst, N.J. 07071-9836

BOND NO. WF12514 $ 59,000.00

KNOWN ALL MEN BY THESE PRESENTS: That we, the undersigned Kevin Emmert Construction Co. as Principal, and Westchester Fire Insurance Company, a corporation of the New York and authorized to do business in the State of , as Surety, are hereby held and firmly bound unto the Hamilton County Commissioners as Obligee, in the penal sum of Fifty nine thousand and 00/100 ($ 59,000.00) Dollars for the payment of which, well and truly to be made we hereby jointly and severally bind ourselves, our heirs, executors, administrators, successors, and assigns.

WHEREAS, it is proposed to make certain

drainage work at Deerwalk Estates as per attached cost estimate.

WHEREAS, the Hamilton County Commissioners has approved said plan upon the execution and delivery of this bond.

NOW, THEREFORE, the condition of this obligation is such that if the above bounden Principal shall construct the improvements shown above, and complete said work to satisfaction of the Hamilton County Commissioners and in accordance with the present standard specifications of the Hamilton County Commissioners therefore, then this obligation shall be void, otherwise the same remain in full force and effect; it being expressly understood and agreed that the liability of the Surety for any and all claims hereunder shall in no event exceed the penal amount of this obligation as herein stated.

Signed, sealed and dated this May 16, 1990

Kevin Emmert Construction Co.
Principal

Witness

BY Kevin W. Emmert

Westchester Fire Insurance Company
Surety

Witness

BY Mary L. Paduzzi
Mary L. Paduzzi, Attorney-in-Fact

This copy printed from the Digital Archive of the Hamilton County Surveyor's Office; One Hamilton Co. Square, Ste. 188, Noblesville, In 46060

FORM #WF 015 (7/89) (3M)

WESTCHESTER FIRE INSURANCE COMPANY

NEW YORK, NEW YORK

STATEMENT AS OF DECEMBER 31, 1989

ASSETS

Bonds		$1,110,906,748
Stocks:		
Preferred	$ 4,041,554	
Common	324,638,780	328,680,334
Real Estate		8,043,993
Cash and Bank Deposits		1,350,081
Short Term Investments		82,356,307
Other Invested Assets		3,474,114
Premium Balances Receivable		112,854,499
Equities and Deposits in Pools and Associations		3,834,848
Other Assets		30,582,024
Total Admitted Assets		**$1,682,082,948**

LIABILITIES AND SURPLUS

Losses and Adjustment Expenses		$ 994,964,202
Taxes and Expenses		34,382,611
Unearned Premiums		195,097,716
Other Liabilities		91,735,334
Capital	$ 2,500,000	
Paid in and Contributed Surplus	130,160,715	
Other Surplus	233,242,370	
Surplus to Policyholders		365,903,085
Total Liabilities and Surplus		**$1,682,082,948**

Bonds and Stocks are valued in accordance with the basis adopted by the National Association of Insurance Commissioners.

Securities carried at $138,721,850 in the above statement are deposited as required by law.

STATE OF NEW JERSEY
COUNTY OF MORRIS } *SS:*

GEORGE J. RACHMIEL, Senior Vice President & Treasurer and MICHAEL A. SANDRI, Vice President of the Westchester Fire Insurance Company being duly sworn, each for himself deposes and says that they are the above described officers of the said Company and that on the 31st day of December, 1989 the Company was actually possessed of the assets set forth in the foregoing statement and that such assets were available for the payment of losses and claims and held for the protection of its policyholders and creditors, except as hereinbefore indicated, and that the foregoing statement is a correct exhibit of such assets and liabilities of the said Company on the 31st day of December, 1989 according to the best of their information, knowledge and belief, respectively.

George J. Rachmiel
Senior Vice President & Treasurer

Michael A. Sandri
Vice President

Corporation's Seal

Sworn to and Subscribed before me this
6th day of April, 1990.

Cynthia Jo Stehli

CYNTHIA JO STEHLI
NOTARY PUBLIC OF NEW JERSEY
My Commission Expires Dec. 13, 1993

Notarial Seal

This copy printed from the Digital Archive of the Hamilton County Surveyor's Office; One Hamilton Co. Square, Ste. 188, Noblesville, In 46060

POWER OF ATTORNEY
WESTCHESTER FIRE INSURANCE COMPANY
PRINCIPAL OFFICE, NEW YORK, N.Y.

KNOW ALL MEN BY THESE PRESENTS: That the WESTCHESTER FIRE INSURANCE COMPANY a Corporation duly organized and existing under the laws of the State of New York, and having its administrative offices in the Township of Morris, New Jersey, has made, constituted and appointed, and does by these presents make, constitute and appoint Robert A. Nicosia, Richard L. Quackenbush, Mary L. Paluzzi, Margaret A. Nicosia, Thomas Piccinnino, and Richard Ingram of Nutley, New Jersey, each

its true and lawful Agent(s) and Attorney(s)-in-Fact, with full power and authority hereby conferred in its name, place and stead, to execute, seal, acknowledge and deliver: Any and all bonds and undertakings--

and to bind the Corporation thereby as fully and to the same extent as if such bonds had been duly executed and acknowledged by the regularly elected officers of the Corporation at its offices in Morris Township, New Jersey in their own proper persons.

This Power of Attorney limits the act of those named therein to the bonds and undertakings specifically named therein, and they have no authority to bind the Company except in the manner and to the extent therein stated.

This Power of Attorney revokes all previous powers issued in behalf of the attorney(s)-in-fact named above.

IN WITNESS WHEREOF the Westchester Fire Insurance Company has caused these presents to be signed and attested by its appropriate officers and its corporate seal hereunto affixed this 27th day of June, 19 89.

Attest:

Assistant Secretary
John K. Stewart

WESTCHESTER FIRE INSURANCE COMPANY

Vice President
Richard A. Annese

STATE OF NEW JERSEY)
COUNTY OF MORRIS) ss.:

On this 27th day of June 19 89, before the subscriber, a duly qualified Notary Public of the State of New Jersey, came the above-mentioned Vice President and Assistant Secretary of the Westchester Fire Insurance Company, to me personally known to be the officers described in, and who executed the preceding instrument, and they acknowledged the execution of the same, and, being by me duly sworn, deposed and said, that they are the officers of said Company aforesaid, and that the seal affixed to the preceding instrument is the Corporate Seal of said Company, and the said Corporate Seal and their signatures as officers were duly affixed and subscribed to the said instrument by the authority and direction of the said Company.

IN TESTIMONY WHEREOF, I have hereunto set my hand and affixed my seal at the Township of Morris, the day and year first above written.

DAWN M. BIAMONTE
NOTARY PUBLIC OF NEW JERSEY
MY COMMISSION EXPIRES JULY 25, 1993

(Signed)
(Seal)

Notary Public

FORM #WF-002 (7/89) (3M)

This copy printed from the Digital Archive of the Hamilton County Surveyor's Office, One Hamilton Co. Square, Ste. 188, Noblesville, IN 46060

This Power of Attorney is granted pursuant to Article IV of the By-Laws of the WESTCHESTER FIRE INSURANCE COMPANY as now in full force and effect.

ARTICLE IV Execution of Instruments. "The Chairman of the Board, Vice-Chairman of the Board, President, or any Vice-President, in conjunction with the Secretary, or any Secretary, if more than one shall be appointed by the Board, or an Assistant Secretary, shall have power on behalf of the Corporation:

(a) to execute, affix the corporate seal manually or by facsimile to, acknowledge, verify and deliver any contracts, obligations, instruments and documents whatsoever in connection with its business including, without limiting the foregoing, any bonds, guarantees, undertakings, recognizances, powers of attorney or revocations of any powers of attorney, stipulations, policies of insurance, deeds, leases, mortgages, releases, satisfactions and agency agreements;

(b) to appoint, in writing, one or more persons for any or all of the purposes mentioned in the preceding paragraph (a), including affixing the seal of the Corporation."

This Power of Attorney is signed and sealed under and by the authority of Article III, Section 9 of the By-Laws of the WESTCHESTER FIRE INSURANCE COMPANY as now in full force and effect.

ARTICLE III Section 9 Facsimile Signatures. "The signature of any officer authorized by the Corporation to sign any bonds, guarantees, undertakings, recognizances, stipulations, powers of attorney or revocations of any powers of attorney and policies of insurance issued by the Corporation may be printed facsimile, lithographed, or otherwise produced . . . The Corporation may continue to use for the purposes herein stated the facsimile signature of any person or persons who shall have been such officer or officers of the Corporation, notwithstanding the fact that he may have ceased to be such at the time when such instruments shall be issued."

CERTIFICATE

State of New Jersey
County of Morris

I, the undersigned, Assistant Secretary of the WESTCHESTER FIRE INSURANCE COMPANY, DO HEREBY CERTIFY that the foregoing POWER OF ATTORNEY remains in full force and effect and has not been revoked and furthermore that the above quoted abstracts of Article IV and Article III, Section 9 of the By-Laws of the Corporation are now in full force and effect.

Signed and sealed at the Township of Morris, New Jersey dated 16th

day of May, 1990.

By Herbert H. Linder
Assistant Secretary
Herbert H. Linder

This copy printed from the Digital Archive of the Hamilton County Surveyor's Office; One Hamilton Co. Square, Ste. 188, Noblesville, In 46060

ASSOCIATED INSURANCE MANAGERS
6308 Rucker Rd., Suite A
P. O. Box 55570
Indianapolis, Indiana 46205
317-253-1402
FAX 317-254-9834

☐ Box 940, Anderson 46015
317-644-3331
☑ Box 55570, Indianapolis 46205
317-253-1402
☐ Box 5582, Evansville 47716
812-479-5050

From: STEVE KUYKENDALL

DEERWALK

To: HAMILTON COUNTY SURVEYORS OFFICE
942 MAPLE AVENUE
NOBLESVILLE IN. 46060

ATTN: JERRY LISTON

Subject: KEVIN EMMERT CONSTRUCTION

Date: 6-25-91

Dear Mr. Liston,

Per our clients request, please find attached Irrevocable Letter of Credit that we have in force as support for their Subdivision Bonds at Deerwalk Estates.

Sincerely,
Steve Kuykendall

Please Reply Below

Date:

Bond Agent for Kevin Emmert Construction

FILED

HAMILTON COUNTY DRAINAGE BOARD

This copy printed from the Digital Archive of the Hamilton County Surveyor's Office; One Hamilton Co. Square, Ste. 188, Noblesville, In 46060

SENDER: KEEP PINK COPY, SEND WHITE AND YELLOW.

RECIPIENT: RETURN YELLOW COPY WITH REPLY.

Ameritrust.

Irrevocable Letter of Credit No. 323
Expiration Date 5-11-92

Ameritrust National Bank
Central Indiana
110 North 9th Street
P O Box 40
Noblesville, IN 46060-9987
(317) 773-0980
FAX: (317) 773-5543

Universal Bonding Insurance Company
518 Stuyvesant Avenue
P.O. Box 615
Lyndhurst, N.J. 07071-9836

Beneficiaries:

By order of our client, Kevin W. and Denise Emmert, we hereby establish this Irrevocable Letter of Credit No. 323 in your favor for an amount up to but not exceeding the aggregate sum of Twenty-Eight Thousand Dollars and 00/100($28,000), effective immediately, and expiring at the offices of the bank on May 11, 1992 unless renewed as hereinafter provided.

Funds under this Letter of Credit are available to you against your sight draft(s), signed by your authorized corporate officer, drawn on us bearing the clause "Drawn under Credit No. 323".

This Letter of Credit will be automatically renewed for a one year period upon the expiration date set forth above and upon each anniversary of such date, unless at least sixty (60) days prior to such expiration date, or prior to any anniversary of such date, we notify both you and our client in writing by certified mail that we elect not to so renew this Letter of Credit.

Upon receipt by you of our notice of election not to renew this Letter of Credit, you may draw hereunder by your sight draft (s) drawn on us and bearing the clause "Drawn under Credit No. 323".

This Letter of Credit sets forth in full the terms of our undertaking and such undertaking shall not in any way be modified, amended or amplified by reference to any documents or instrument referred to herein or in which this Letter of Credit is referred to or to which this Letter of Credit relates and any such reference shall not be deemed to incorporate herein by reference any document or instrument.

All bank charges and commissions incurred in this transaction are for the applicant's account. Any funds drawn hereunder and unused at the time you are discharged as Surety on all bond(s) or undertaking(s) on behalf of our client will be repaid to us by you.

This copy printed from the Digital Archive of the Hamilton County Surveyor's Office; One Hamilton Co. Square, Ste. 188, Noblesville, In 46060

Letter of Credit No. 323
Ameritrust National Bank

We hereby agree with the drawers, endorsers, and bonafide holders of drafts drawn under and in compliance with the terms of this credit that such drafts will be duly honored upon presentation to the drawee.

Except as otherwise expressly stated herein, this credit is subject to the Uniform Customs and Practice for Commercial Documentary Credits (1983 Revision) I.C.C. Publication No. 400.

Sincerely,

Ameritrust National Bank
Charles L. Crow
Vice-President

This copy printed from the Digital Archive of the Hamilton County Surveyor's Office; One Hamilton Co. Square, Ste. 188, Noblesville, In 46060

WESTCHESTER FIRE INSURANCE COMPANY
518 Stuyvesant Avenue
P.O. Box 615
Lyndhurst, N.J. 07071-9836

BOND NO. WF12514 $ 59,000.00

KNOWN ALL MEN BY THESE PRESENTS: That we, the undersigned Kevin Emmert Construction Co. as Principal, and Westchester Fire Insurance Company, a corporation of the New York and authorized to do business in the State of , as Surety, are hereby held and firmly bound unto the Hamilton County Commissioners as Obligee, in the penal sum of Fifty nine thousand and 00/100 ($ 59,000.00) Dollars for the payment of which, well and truly to be made we hereby jointly and severally bind ourselves, our heirs, executors, administrators, successors, and assigns.

WHEREAS, it is proposed to make certain

drainage work at Deerwalk Estates as per attached cost estimate.

WHEREAS, the Hamilton County Commissioners has approved said plan upon the execution and delivery of this bond.

NOW, THEREFORE, the condition of this obligation is such that if the above bounden Principal shall construct the improvements shown above, and complete said work to satisfaction of the Hamilton County Commissioners and in accordance with the present standard specifications of the Hamilton County Commissioners therefore, then this obligation shall be void, otherwise the same remain in full force and effect; it being expressly understood and agreed that the liability of the Surety for any and all claims hereunder shall in no event exceed the penal amount of this obligation as herein stated.

Signed, sealed and dated this May 16, 1990

Kevin Emmert Construction Co.
Principal

Witness

BY Kevin W. Emmert

Westchester Fire Insurance Company
Surety

Witness

BY Mary L. Paduzzi
Mary L. Paduzzi, Attorney-in-Fact

This copy printed from the Digital Archive of the Hamilton County Surveyor's Office; One Hamilton Co. Square, Ste. 188, Noblesville, In 46060

FORM #WF 015 (7/89) [3M]

SURVEYOR'S OFFICE

Hamilton County

Kenton C. Ward, Surveyor
Phone (317) 776-8495
Fax (317) 776-9628

Suite 146
One Hamilton County Square
Noblesville, Indiana 46060-2230

To: Hamilton County Drainage Board

June 10, 1997

Re: **Deerwalk Estates Drain - Sec. 1 arm**

Attached are as-builts, certificate of completion & compliance, and other information for Deerwalk Estates. An inspection of the drainage facilities for this section has been made and the facilities were found to be complete and acceptable.

During construction, changes were made to the drain which will alter the plans submitted with my report for this drain dated June 13, 1990. The changes are as follows:
The 48" CMP was lengthened from 70' feet to 85' feet.
The corrected totals are as follows: 12" RCP - 393' feet, 15" RCP - 150' feet.
The length of the drain due to the changes described above is now **3,589 feet.**

The non-enforcement was approved by the Board at its meeting on August 20, 1990 and recorded under instrument #9022187.

The bond or letter of credit from Westchester Fire Insurance Co. & Ameritrust, number WF 12514 and 323, dated May 16, 1990 & June 1991, in the amount of $59,000.00 for storm sewers and $28,000.00 for the extension, has been recommended for release in a letter to the Commissioners dated may 11, 1992.

I recommend the Board approve the drains construction as complete and acceptable.

Sincerely,

Kenton C. Ward,
Hamilton County Surveyor

KCW/slm

This copy printed from the Digital Archive of the Hamilton County Surveyor's Office; One Hamilton Co. Square, Ste. 188, Noblesville, In 46060

Asbuilt Structures

Project: Deerwalk Estates

Structure:	T.C.:	I.E.:	Pipe:	Length:	Original Plans:	Difference:
STR 5	795.91	792.49				
STR 4	795.94	792.43	12"	26'		
STR 4	795.94	792.43				
STR 3	795.53	792.19	12"	121'		
STR 3	795.53	792.09				
MES	—	791.89	12"	7'		
STR 2	797.05	793.64				
STR 1	797.33	792.97	12"	26'		
STR 1	797.33	792.90				
MES	—	783.16	12"	59'		
MES	—	803.98				
STR 7	803.99	800.28	12"	20'		
STR 7	803.99	800.17				
STR 6	803.81	799.65	12"	26'		
STR 6	803.81	799.60				
MES	—	798.39	15"	150'		
STR 8	798.29	786.15				
MES	—	773.06	12"	110'		

6" SSD Streets:

Total: _____

6" SSD Lots:

Total: _____

RCP Pipe Totals:

Other Drain:	

Total Length of Drain: _____

This copy printed from the Digital Archive of the Hamilton County Surveyor's Office; One Hamilton Co. Square, Ste. 188, Noblesville, In 46060

Asbuilt Structures

Project: Deerwalk Estates

Structure:	T.C.:	I.E.:	Pipe:	Length:	Original Plans:	Difference:
LOT 19 & 20	—	783.84	142"x91"	96'		
		783.16	CMP			
LOT 10 & 11	—	773.34				
		773.06	48" CMP	85'	FROM 70'	+15

6" SSD Streets:

6" SSD Lots:

Lot 18	80'
14-15	460

Total: _____

555 ok

Total: 540

RCP Pipe Totals:

12"	393'
15"	150'

Other Drain:	
48" CMP	85'
142" x 91" CMP	96'
OPEN DITCH	2310'

Total Length of Drain: 3589'

This copy printed from the Digital Archive of the Hamilton County Surveyor's Office; One Hamilton Co. Square, Ste. 188, Noblesville, In 46060

MARBAUGH N33671

GENERAL NOTES:

IT IS THE RESPONSIBILITY OF EACH CONTRACTOR TO VERIFY ALL EXISTING UTILITIES AND CONDITIONS PERTAINING TO HIS PHASE OF THE WORK. IT SHALL BE THE CONTRACTORS RESPONSIBILITY TO CONTACT THE OWNERS OF THE VARIOUS UTILITIES BEFORE WORK IS STARTED. THE CONTRACTOR SHALL NOTIFY IN WRITING THE OWNERS OR THE ENGINEER OF ANY CHANGES, ERRORS OR OMISSIONS FOUND ON THESE PLANS OR IN THE FIELD BEFORE WORK IS STARTED OR RESUMED.

STANDARD SPECIFICATIONS SHALL APPLY FOR ALL WORK AND MATERIAL.

THE CONTRACTOR SHALL BE RESPONSIBLE FOR OBTAINING ALL STATE, CITY AND COUNTY PERMITS.

CONTRACTOR SHALL CHECK WITH THE ENGINEER PRIOR TO THE START OF CONSTRUCTION TO VERIFY DATE OF PLANS.

ALL CONTRACTORS SHALL VERIFY SUBSURFACE CONDITIONS PRIOR TO BIDDING.

UNDERGROUND TILES NOT VISIBLE ON THE SURFACE MAY EXIST. ANY TILES ENCOUNTERED DURING CONSTRUCTION SHALL BE MAINTAINED WITH POSITIVE DRAINAGE.

EASEMENT SHALL BE PROVIDED ALONG ALL UTILITY LINES.

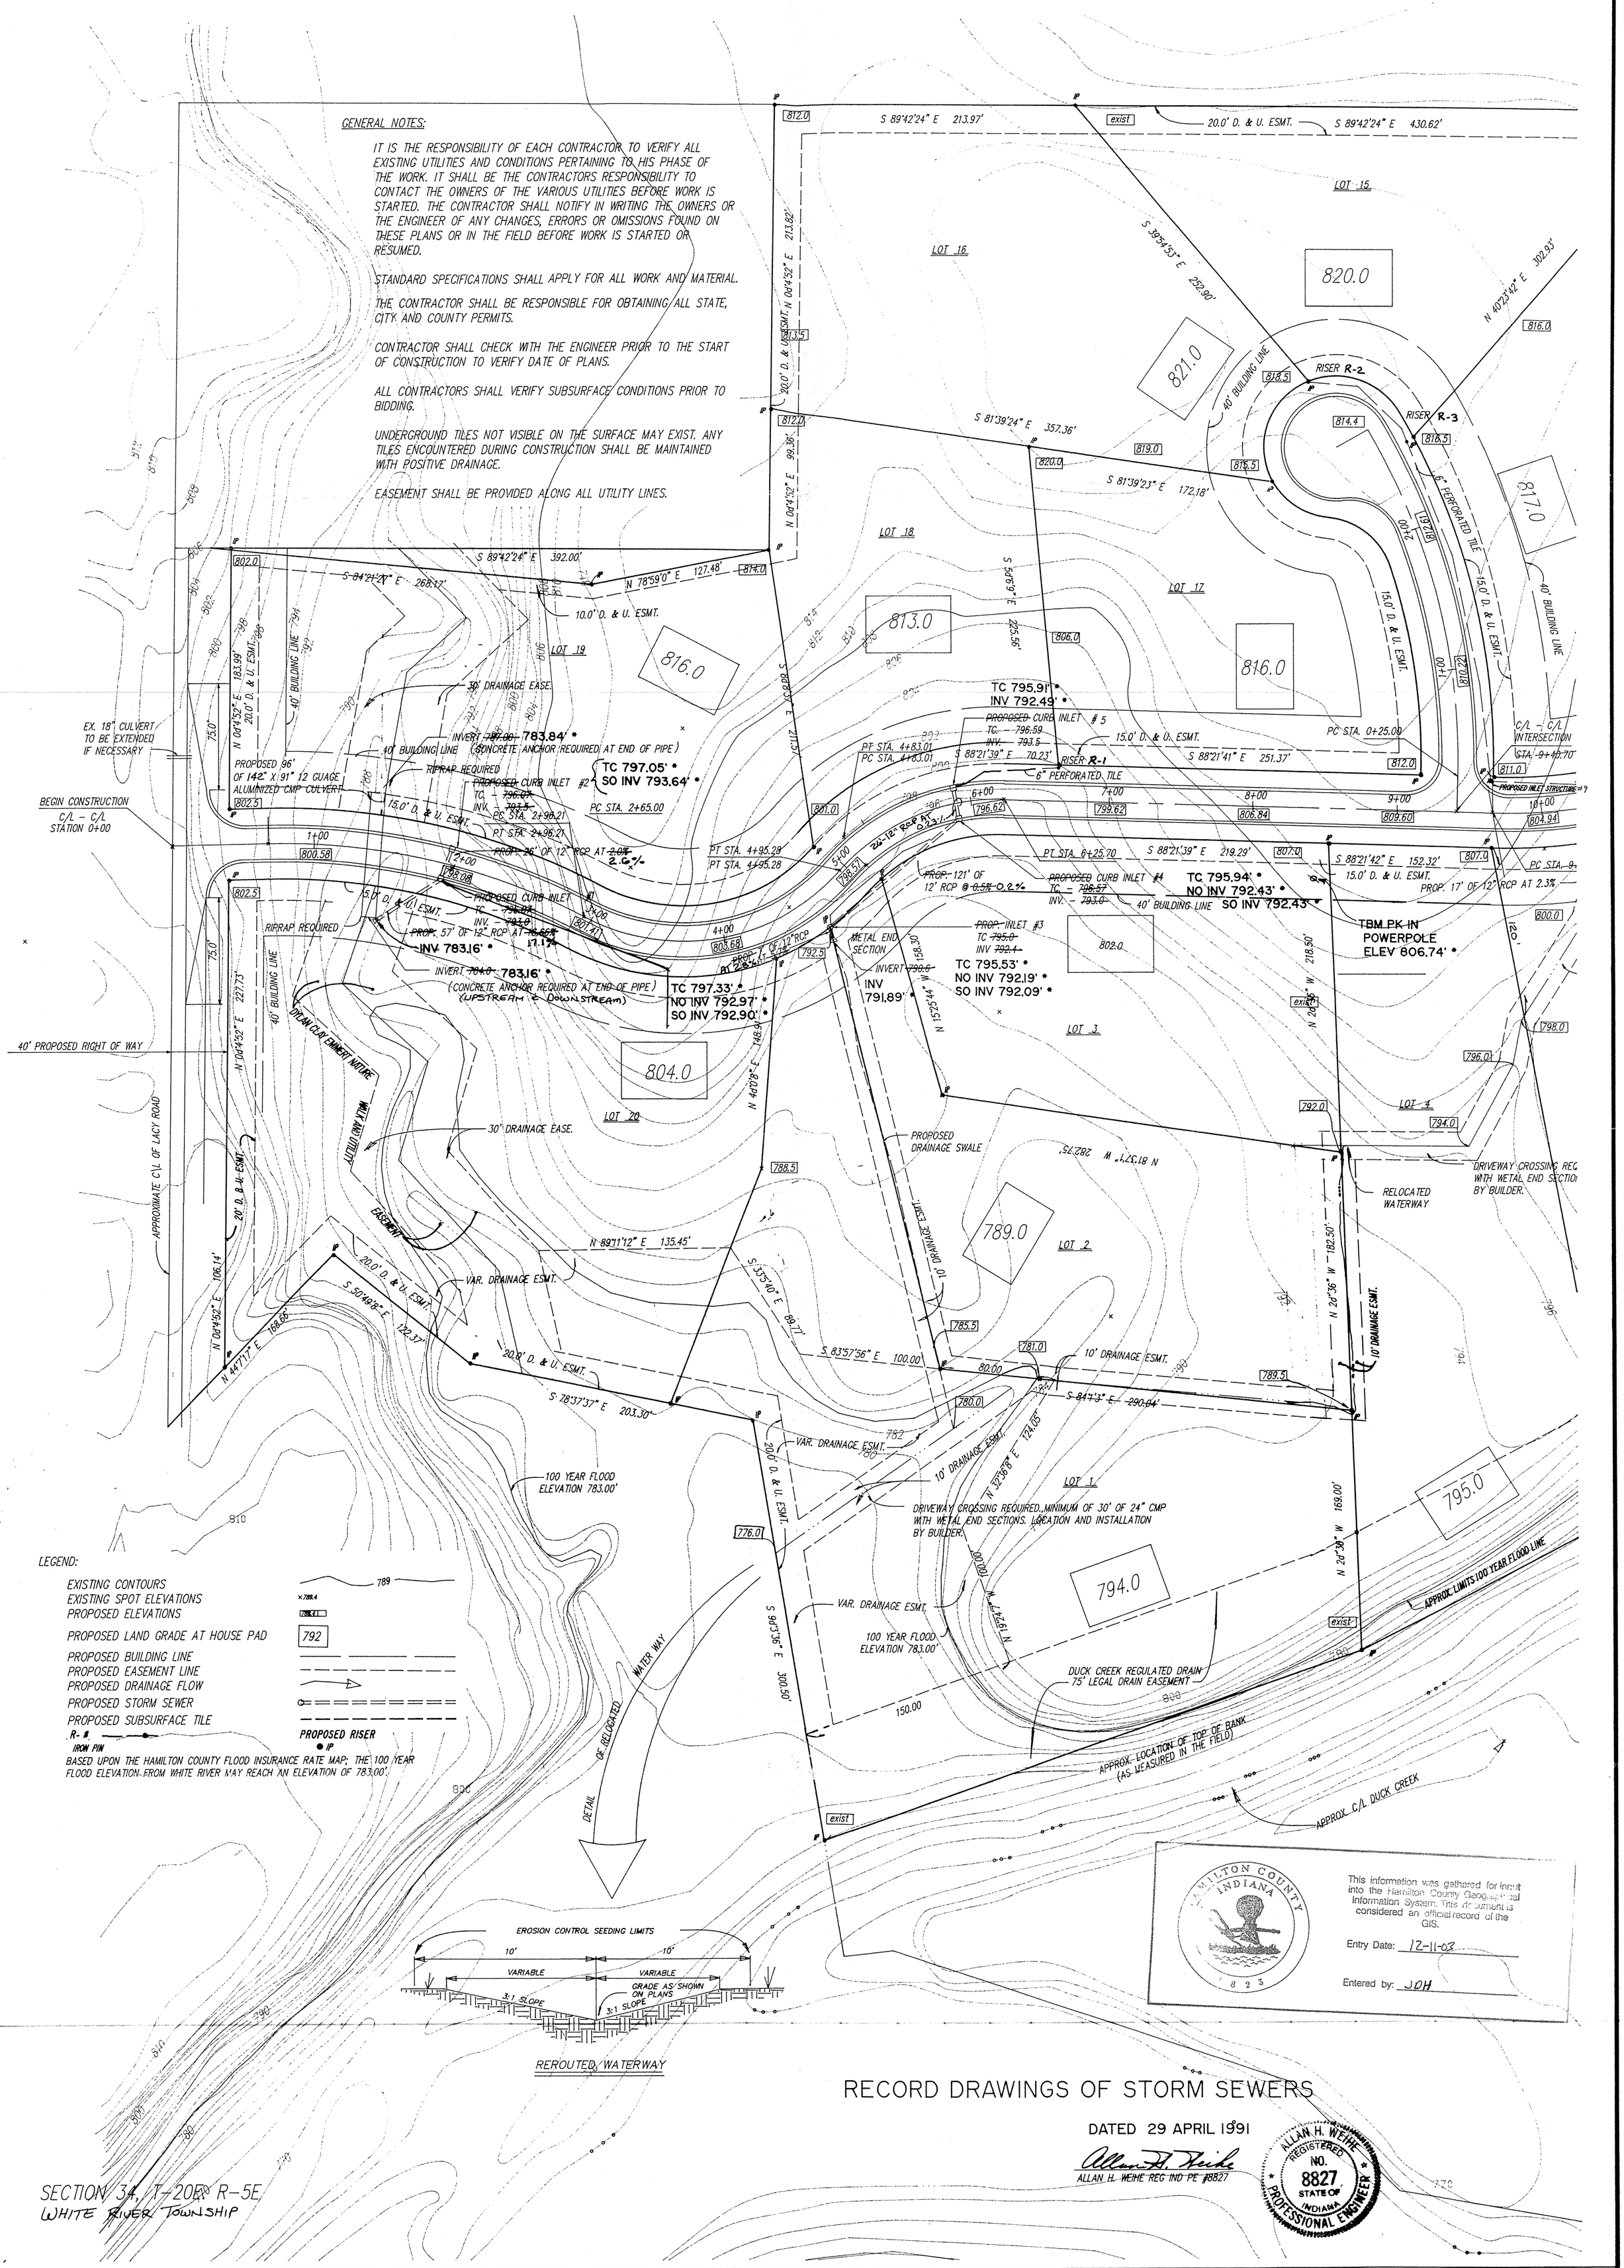

RECORD DRAWINGS OF STORM SEWERS

DATED 29 APRIL 1991

ALLAN H. WEIHE REG IND PE #8827

ALLAN H. WEIHE REGISTERED NO. 8827 STATE OF INDIANA PROFESSIONAL ENGINEER

SECTION 34, T-20N R-5E
WHITE RIVER TOWNSHIP

SHEET NO 4 OF 8

PREPARED FOR:
DEERWALK
KEVIN EMMERT
NOBLESVILLE, INDIANA 46060

DEVELOPMENT PLAN SCALE: 1" = 50'

REVISIONS	DATE	BY

F.B. PAGE #

JOB NO. 89-1480
DRAWN BY O'B
CHECKED BY A.H.W.
DATE

WEIHE ENGINEERS INC.
10505 NORTH COLLEGE AVENUE
INDIANAPOLIS, INDIANA 46280
(317) 846-6611

ALLAN H. WEIHE, P.E., L.S.
PRESIDENT

CIVIL ENGINEERS LAND SURVEYORS LAND PLANNERS

This copy printed from the Digital Archive of the Hamilton County Surveyor's Office; One Hamilton Co. Square, Ste. 188, Noblesville, In 46060

MARBAUGH N33671

LEGEND:

EXISTING CONTOURS — 789
EXISTING SPOT ELEVATIONS — ×789.4
PROPOSED ELEVATIONS — 786.41
PROPOSED LAND GRADE AT HOUSE PAD — 792
PROPOSED BUILDING LINE
PROPOSED EASEMENT LINE
PROPOSED DRAINAGE FLOW
PROPOSED STORM SEWER
PROPOSED SUBSURFACE TILE
IRON PIN — IP

BASED UPON THE HAMILTON COUNTY FLOOD INSURANCE RATE MAP, THE 100 YEAR FLOOD ELEVATION FROM WHITE RIVER MAY REACH AN ELEVATION OF 783.00'.

GENERAL NOTES:

IT IS THE RESPONSIBILITY OF EACH CONTRACTOR TO VERIFY ALL EXISTING UTILITIES AND CONDITIONS PERTAINING TO HIS PHASE OF THE WORK. IT SHALL BE THE CONTRACTORS RESPONSIBILITY TO CONTACT THE OWNERS OF THE VARIOUS UTILITIES BEFORE WORK IS STARTED. THE CONTRACTOR SHALL NOTIFY IN WRITING THE OWNERS OR THE ENGINEER OF ANY CHANGES, ERRORS OR OMISSIONS FOUND ON THESE PLANS OR IN THE FIELD BEFORE WORK IS STARTED OR RESUMED.

STANDARD SPECIFICATIONS SHALL APPLY FOR ALL WORK AND MATERIAL.

THE CONTRACTOR SHALL BE RESPONSIBLE FOR OBTAINING ALL STATE, CITY AND COUNTY PERMITS.

CONTRACTOR SHALL CHECK WITH THE ENGINEER PRIOR TO THE START OF CONSTRUCTION TO VERIFY DATE OF PLANS.

ALL CONTRACTORS SHALL VERIFY SUBSURFACE CONDITIONS PRIOR TO BIDDING.

UNDERGROUND TILES NOT VISIBLE ON THE SURFACE MAY EXIST. ANY TILES ENCOUNTERED DURING CONSTRUCTION SHALL BE MAINTAINED WITH POSITIVE DRAINAGE.

EASEMENT SHALL BE PROVIDED ALONG ALL UTILITY LINES.

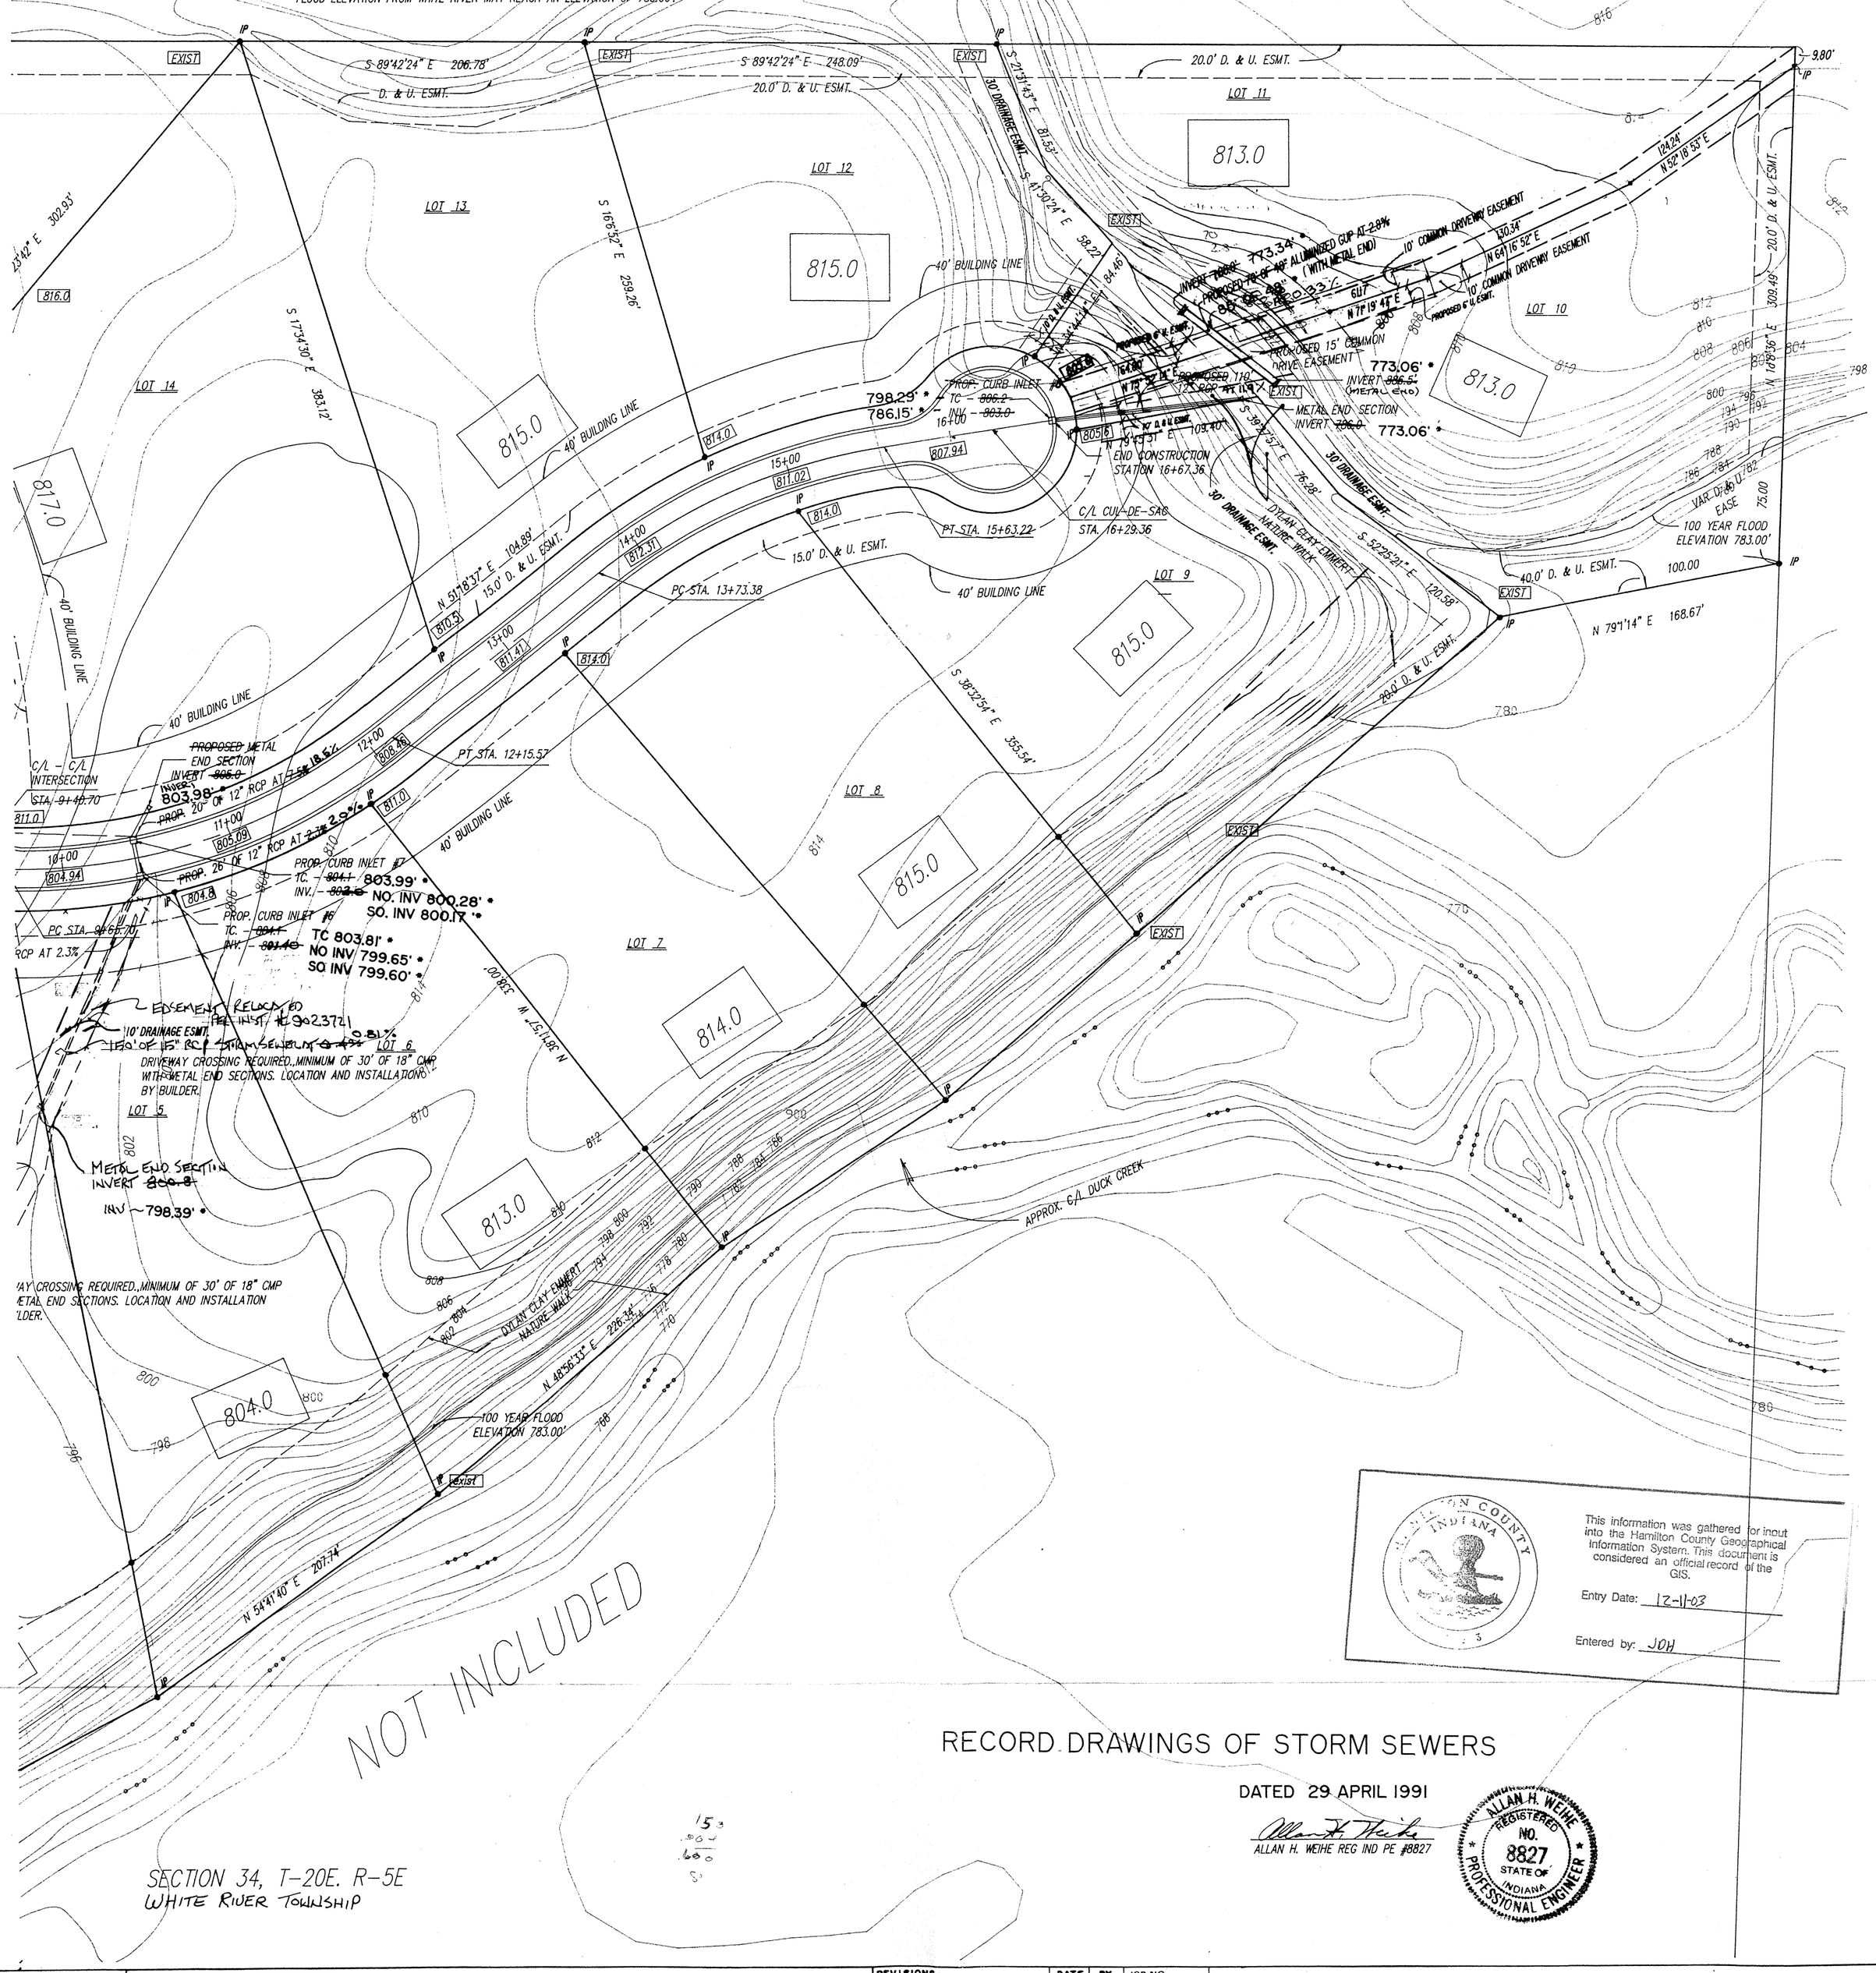

SECTION 34, T-20E. R-5E
WHITE RIVER TOWNSHIP

HAMILTON COUNTY INDIANA

This information was gathered for input into the Hamilton County Geographical Information System. This document is considered an official record of the GIS.

Entry Date: 12-11-03

Entered by: JOH

RECORD DRAWINGS OF STORM SEWERS

DATED 29 APRIL 1991

ALLAN H. WEIHE REG IND PE #8827

ALLAN H. WEIHE REGISTERED NO. 8827 STATE OF INDIANA PROFESSIONAL ENGINEER

SHEET NO 5 OF 8

PREPARED FOR:
DEERWALK
KEVIN EMMERT
NOBLESVILLE, INDIANA 46060

DEVELOPMENT PLAN SCALE: 1" = 50'

REVISIONS	DATE	BY
Rev Storm	10/18	

F.B. PAGE #

JOB NO. 89.1480
DRAWN BY O'B
CHECKED BY A.H.W.
DATE

WEIHE ENGINEERS INC.
10505 NORTH COLLEGE AVENUE
INDIANAPOLIS, INDIANA 46280
(317) 846-6611
ALLAN H. WEIHE, P.E., L.S.
PRESIDENT
CIVIL ENGINEERS LAND SURVEYORS LAND PLANNERS

This copy printed from the Digital Archive of the Hamilton County Surveyor's Office; One Hamilton Co. Square, Ste. 188, Noblesville, In 46060