Drain: FAIRFIELD FARMS DRAIN **Drain #:** 242

Improvement/Arm: FAIRFIELD FARMS - SECTION 2

Operator: JDH **Date:** 12-12-03

Drain Classification: **Urban/Rural** **Year Installed:** 1992

GIS Drain Input Checklist

- Pull Source Documents for Scanning — JH 12-12
- Digitize & Attribute Tile Drains — N/A
- Digitize & Attribute Storm Drains — JH 12-12
- Digitize & Attribute SSD — N/A
- Digitize & Attribute Open Ditch — JH 12-12
- Stamp Plans — JH 12-12
- Sum drain lengths & Validate — JH 12-12
- Enter Improvements into Posse — JH 12-12
- Enter Drain Age into Posse
- Sum drain length for Watershed in Posse
- Check Database entries for errors — JH 12-12

This copy printed from the Digital Archive of the Hamilton County Surveyor's Office; One Hamilton Co. Square, Ste. 188, Noblesville, In 46060

Gasb 34 Footages for Historical Cost
Drain Length Log

Drain-Improvement: FAIRFIELD FARMS DRAIN - FAIRFIELD FARMS-SECTION 2

Drain Type:	Size:	Length (SURVEYORS REPORT)	Length (DB Query)	Length Reconcile	If Applicable Price:	If Applicable Cost:
RCP	12"	1,063'	1,063'	Ø	$7.25	$7,706.75
	15"	628'	628'	Ø	9.50	5,966.00
	18"	633'	633'	Ø	10.50	6,646.50
CONC. SWALE		595'	540'	-55'	$15.00	8,100.00
Sum:		2,919'	2864'	-55'		$28,419.25

Final Report: _____

Comments:

AS BUILT LENGTH DIFFERS FROM SURVEY REPORT FOR CONC. SWALE

This copy printed from the Digital Archive of the Hamilton County Surveyor's Office; One Hamilton Co. Square, Ste. 188, Noblesville, In 46060

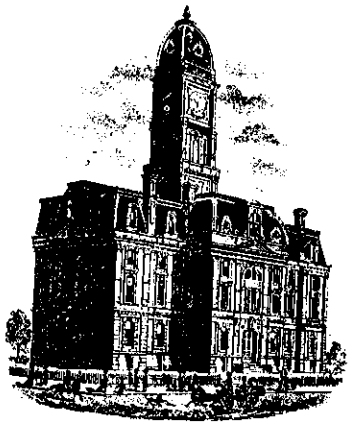

SURVEYOR'S OFFICE

Hamilton County

Kenton C. Ward, Surveyor

776-9626

942 Maple Avenue
Noblesville, Indiana 46060

February 7, 1992

TO: Hamilton County Drainage Board

RE: Fairfield Farms Drain-Section 2

Attached is a petition, non-enforcement request, plans, calculations, quantity summary and assessment roll for the Fairfield Farms Drain-Section 2

I have reviewed the submittals and petition and have found each to be in proper form. I have made a personal inspection of the land described in the petition. Upon doing so, I believe that the drain is practicable; will improve the public health; benefit a public highway and be of public utility; and that the costs, damages and expenses of the proposed drain will probably be less than the benefits accruing to the owners of land likely to be benefitted. The drain will consist of the following:

Concrete Ditch	595 ft	RCP-15"	487 ft
RCP-12"	1031 ft	RCP-18"	548 ft

The total length of the drain will be 2651 feet.

The drainage facilities shown above as concrete ditch is that shown in the detention facility at the rear of Lots 55,56,57, and between Lots 57 and 58 and that shown on Sheet S-11, through the detention facility which abuts the West property line of Lot 92. The detention facilities shall not be maintained as regulated drain outside of this ditch. Other than to ensure no unauthorized structure or filling occurs which will be detrimental to the facilities capacity and function. The homeowners are responsible for the maintenance of the detention facilities.

I have reviewed the plans and believe the drain will benefit each lot equally. I recommend a maintenance assessment of $30.00 per lot, $5.00 per acre for roadways, with a $30.00 minimum. With this assessment the total annual assessment for the drain/this section will be $ 1333.06.

This copy printed from the Digital Archive of the Hamilton County Surveyor's Office; One Hamilton Co. Square, Ste. 188, Noblesville, In 46060

I recommend a hearing be set for April 1992. I also recommend the Board approve the attached non-enforcement request if approved at hearing.

Kenton C. Ward
Hamilton County Surveyor

april

This copy printed from the Digital Archive of the Hamilton County Surveyor's Office; One Hamilton Co. Square, Ste. 188, Noblesville, In 46060

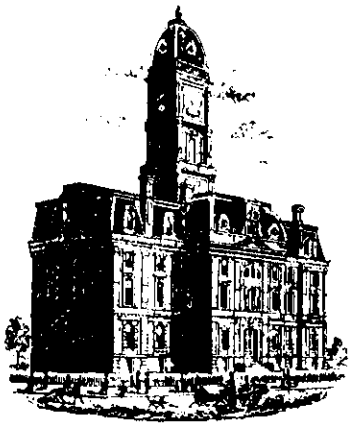

SURVEYOR'S OFFICE

Hamilton County

Kenton C. Ward, Surveyor
Phone (317) 776-8495
Fax (317) 776-9628

Suite 146
One Hamilton County Square
Noblesville, Indiana 46060-2230

To: Hamilton County Drainage Board

September 17, 1997

Re: **Fairfield Farms Drain: Sec. 2 arm**

Attached are as-builts, certificate of completion & compliance, and other information for Fairfield Farms Sec. 2. An inspection of the drainage facilities for this section has been made and the facilities were found to be complete and acceptable.

During construction, changes were made to the drain which will alter the plans submitted with my report for this drain dated February 7, 1992. The changes are as follows:
12" RCP 1063 feet 15" RCP 628 feet 18" RCP 633 feet
Concrete Swale 595 feet

The length of the drain due to the changes described above is now **2,919 feet.**

The non-enforcement was approved by the Board at its meeting on April 20, 1992 and recorded under instrument #9215125.

The bond or letter of credit was not required.

I recommend the Board approve the drains construction as complete and acceptable.

Sincerely,

Kenton C. Ward,
Hamilton County Surveyor

KCW/slm

This copy printed from the Digital Archive of the Hamilton County Surveyor's Office; One Hamilton Co. Square, Ste. 188, Noblesville, In 46060

Asbuilt Structures

Project: FAIRFIELD FARMS SEC. 2

Structure:	T.C.:	I.E.:	Pipe:	Length:	Original Plans:	Difference:
213	774.30	771.81				
216	774.65	771.59	12"	83' ✓	FRM 86'	
216	774.65	771.40				
215	774.68	771.30	15"	31' ✓	FRM 30'	
215	774.68	771.30				
214	—	770.59	15"	151' ✓		
206	772.99	770.04				
205	772.87	769.70	12"	123' ✓	FRM 124'	
205	772.87	769.70				
204	772.90	769.57	12"	39' ✓	FRM 40'	
204	772.90	769.47				
202	772.83	769.31	15"	44' ✓		
202	772.83	769.31				
201	—	768.31	15"	178' ✓	FRM 179'	
202	772.83	769.70				
203	772.98	769.78	12"	41' ✓	FRM 40'	
210	772.94	770.59				
209	773.53	769.68	12"	42' ✓	FRM 41'	

6" SSD Streets:

Total: _____

6" SSD Lots:

Total: _____

RCP Pipe Totals:

Other Drain:	

Total Length of Drain: _____

This copy printed from the Digital Archive of the Hamilton County Surveyor's Office; One Hamilton Co. Square, Ste. 188, Noblesville, In 46060

Asbuilt Structures

Project: FAIRFIELD FARMS SEC. 2

Structure:	T.C.:	I.E.:	Pipe:	Length:	Original Plans:	Difference:
211	772.91	770.45				
209	773.53	770.28	12"	41'	✓	
209	773.53	769.68				
208	774.02	769.57	18"	52'	✓	FRM 50'
208	774.02	769.57				
207	—	769.34	18"	112'	✓	FRM 114'
227	783.91	781.39				
226	784.01	781.21	12"	31'	✓	FRM 30'
226	784.01	781.21				
225	784.24	780.81	12"	101'	✓	FRM 103'
225	784.24	780.81				
224	782.49	779.79	12"	101'	✓	FRM 102'
223	775.54	772.88				
222	775.52	772.71	12"	30'	✓	
222	775.52	772.71				
221	774.00	771.26	12"	135'	✓	
221	774.00	771.26				
220	773.50	770.05	18"	163'	✓	

6" SSD Streets:

Total: _____

6" SSD Lots:

Total: _____

RCP Pipe Totals:

Other Drain:	

Total Length of Drain: _____

This copy printed from the Digital Archive of the Hamilton County Surveyor's Office; One Hamilton Co. Square, Ste. 188, Noblesville, In 46060

Asbuilt Structures

Project: FAIRFIELD FARMS Sec. 2

Structure:	T.C.:	I.E.:	Pipe:	Length:	Original Plans:	Difference:
220	773.50	769.93				
219	773.03	769.33	18"	94' ✓		
219	773.03	769.33				
218	772.79	769.04	18"	30' ✓		
218	772.79	769.04				
217	—	768.01	18"	182' ✓	FRM 181'	
230	783.27	780.27				
229	784.11	779.31	12"	125' ✓	FRM 127'	
229	784.11	779.31				
228	784.06	779.22	12"	30' ✓		
228	784.06	779.22				
224	782.49	778.49	12"	141' ✓	142'	
224	782.49	778.21				
221	774.26	771.16	15"	224' ✓	FRM 223'	

6" SSD Streets:

Total: _____

6" SSD Lots:

Total: _____

RCP Pipe Totals:

12"	1063'
15"	628'
18"	633'

Other Drain:	
concrete	595'

Total Length of Drain: 2919'

This copy printed from the Digital Archive of the Hamilton County Surveyor's Office; One Hamilton Co. Square, Ste. 188, Noblesville, In 46060

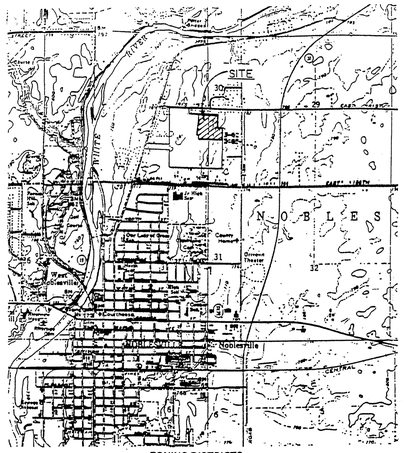

ZONING DISTRICTS

RESIDENTIAL	BUSINESS
SINGLE FAMILY	PBO - PROFESSIONAL RESEARCH AND OFFICE
LOW DENSITY	LB - LOCAL
RE - SUBURBAN	GB - GENERAL
R1 -	AB - ACCOMODATION
MODERATE DENSITY	PB - PLANNED
R2 -	
MODERATE TO HIGH DENSITY	INDUSTRIAL
R3 - *	
R4 - ONE AND TWO FAMILY*	I1 - LIGHT
	I2 - HEAVY
MULTI - FAMILY	
R5 - MEDIUM TO HIGH DENSITY*	
R6 - HIGH DENSITY*	
MOBILE HOME PARK	
MHP	
SPECIAL	AIRPORT - AD
FLOOD HAZARD	PLANNED DEVELOPMENT
FW - FLOODWAY	
FF - FLOODWAY FRINGE	R-PD - RESIDENTIAL
FP - FLOODPLAIN	C-PD - COMMERCIAL
	I-PD - INDUSTRIAL

*SANITARY SEWER AND WATER REQUIRED.

AREA MAP
NOT TO SCALE

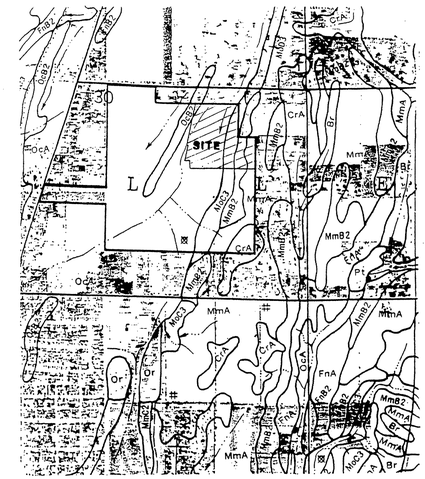

SYMBOL	NAME
Br	Brookston silty clay loam
CrA	Crosby silt loam, 0 to 3 percent slopes
FnA	Fox loam, 0 to 2 percent slopes
FnB2	Fox loam, 2 to 6 percent slopes, eroded
FxC3	Fox clay loam, 6 to 18 percent slopes, severely eroded
Ge	Genesee silt loam
HeF	Hennepin loam, 18 to 50 percent slopes
Ha	Houghton muck
MmA	Miami silt loam, 0 to 2 percent slopes
MmB2	Miami silt loam, 2 to 6 percent slopes, eroded
MmC2	Miami silt loam, 6 to 12 percent slopes, eroded
MmD2	Miami silt loam, 12 to 18 percent slopes, eroded
MoC3	Miami clay loam, 6 to 12 percent slopes, severely eroded
MoD3	Miami clay loam, 12 to 18 percent slopes, severely eroded
MnA	Milton Variant silt loam, 0 to 2 percent slopes
NnA	Nineveh loam, 0 to 2 percent slopes
OcA	Ockley silt loam, 0 to 2 percent slopes
OcB2	Ockley silt loam, 2 to 6 percent slopes, eroded
Or	Orthents
Pa	Palms muck
Pn	Patton silty clay loam
Ps	Patton silty clay loam, limestone substratum
Pt	Pits
Ra	Randolph Variant silt loam
Ro	Ross loam
Sh	Shoals silt loam
St	Sleeth loam
Sk	Sloan silty clay loam, sandy substratum
We	Westland silty clay loam
Wh	Whitaker loam

SOILS MAP
NOT TO SCALE

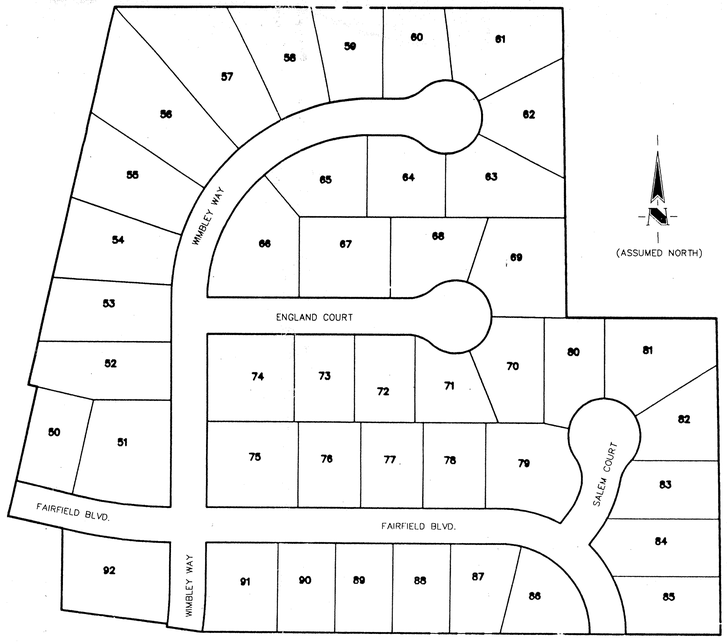

SITE MAP
SCALE: 1"=100'

-SEC. 30-19N-5E-

FAIRFIELD FARMS
SECTION 2

(CONSTRUCTION PLANS)

HAMILTON COUNTY, INDIANA

DEVELOPER:

THOMPSON LAND CO., INC.
11911 LAKESIDE DRIVE
FISHERS, INDIANA 46038
(317) 849-7607

Engineer:

SCHNEIDER ENGINEERING CORP.
3020 NORTH POST ROAD
INDIANAPOLIS, INDIANA 46226
(317) 898-8282

INDEX	
SHEET No.	DESCRIPTION
S-1	TITLE SHEET
S-2	TOPOGRAPHY
S-3	DEVELOPMENT PLAN
S-4	EROSION CONTROL PLAN
S-5,S-6	STREET PLAN
S-7,S-8	SANITARY SEWER PLAN
S-9,S-10	STORM SEWER PLAN
S-11	DRY DETENTION AREA
S-12	WATER DISTRIBUTION PLAN
S-13	WATER DISTRIBUTION DETAILS
S-14,S-15	GENEREAL DETAILS
S-16	SPECIFICATIONS
S-17	LIFT STATION DETAIL
S-18	LIFT STATION SPECIFICATIONS

HAMILTON COUNTY INDIANA 1823
This information was gathered for input into the Hamilton County Geographical Information System. This document is considered an official record of the GIS.
Entry Date: 12-12-03
Entered by: JDH

STORM SEWER RECORD DRAWING

Schneider Engineering Corporation
CIVIL ENGINEERS — LAND SURVEYORS
3020 NORTH POST ROAD
INDIANAPOLIS, INDIANA 46226-6518
(317) 898-8282

CERTIFIED BY: DUANE A. SHARRER

DUANE A. SHARRER REGISTERED LAND SURVEYOR NO. 890258 STATE OF INDIANA PROFESSIONAL ENGINEER

DATE: 9/10/97

FILED SEP 11 1997 OFFICE OF HAMILTON COUNTY SURVEYOR

SHEET 1 OF 18

PROJECT ENGINEER: ICC
CHECKED BY: [illegible]
DATE CHANGED: _____

(JOB No. 708.02)

This copy printed from the Digital Archive of the Hamilton County Surveyor's Office, One Hamilton Co. Square, Ste. 188, Noblesville, In 46060

STORM SEWER SCHEDULE

STR #	STA	OFFSET LT/RT	TYPE	TC	INVERTS
201	14+67.16 'A'	66.90' RT	END SECTION		768.40
202	16+31.78 'A'	20.00' RT	CURB INLET	773.00	769.47 (W&E) 769.88 (N)
203	16+31.78 'A'	20.00' LT	CURB INLET	773.(	770.00 (S)
204	16+75.57 'A'	20.00' RT	CURB INLET	773.00	769.59 (W) 769.83 (N)
205	16+75.57 'A'	20.00' LT	CURB INLET	773.00	770.03 (N&S)
206	1+40.27 'B'	50.00' RT	BEEHIVE INLET	773.40	770.40 (S)
207	2+48.87 'B'	163.61' LT	END SECTION		[illegible]37
208	2+48.87 'B'	50.00' LT	MANHOLE	7[illegible]	[illegible]68 (W)
209	2+85.27 'B'	15.00' LT	CURB INLET	772.95	769.81 (W) [illegible]0.31 (SE) 770.27 (NE)
210	0+20.00 'C'	21.77' RT	CURB INLET	772.95	[illegible] (NW)
211	0+20.00 'C'	22.04' LT	CURB INLET	772.95	[illegible]
213	1+52.30 'C'	137.50' LT	CURB INLET	[illegible]	771.80 (S)
214	5+21.13 'A'	165.51' LT	END SECTION		770.46
215	5+24.19 'B'	15.00' LT	CURB INLET	774.85	771.21 (NW&SE)
216	5+21.13 'B'	15.00' LT	CURB INLET	774.83	771.29 (NW) 771.54 (SE)
217	14+83.92 'A'	86[illegible] RT	END SECTION		767.88
218	16+19.30	[illegible]76' RT	CURB INLET	773.29	769.17 (E&W)
219	16+42.70 'A'	237.05'	CURB INLET	773.29	769.37 (E&W)
220	17+34.65 'A'	2[illegible]65' RT	BEEHIVE INLET	773.50	769.96 (NE&W)
221	18+58.91 'A'	[illegible]RT	BEEHIVE INLET	774.00	771.43 (N) 771.19 (E) 770.94 (SW)
222	18+58.91 'A'	[illegible]00' RT	CURB INLET	775.54	772.91 (S&N)
223	18+58.91 'A'	15.00' LT	CURB INLET	775.54	773.00 (S)
224	20+82.08 'A'	150.00' RT	BEEHIVE INLET	783.00	778.33 (W) 779.96 (NE) 778.58 (E)
225	21+23.40 'A'	50.00' RT	MANHOLE	784.70	781.08 (SW&NE)
226	0+41.78 'E'	15.00' LT	CURB INLET	783.98	781.39 (SW&SE)
227	0+41.78 'E'	15.00' RT	CURB INLET	783.98	781.48 (N&W)
228	23+24.54 'A'	15.00' RT	CURB INLET	784.06	779.51 (W&E)
229	23+24.54 'A'	15.00' LT	CURB INLET	784.06	779.62 (W&E)
23[illegible]	23+24.54 'A'	141.74' LT	BEEHIVE INLET	783.50	780.00 (W)

NOT APPLICABLE SEE PROFILE SHEETS

GENERAL NOTES

1. ALL GRADES AT BOUNDARY SHALL MEET EXISTING GRADES, EXCEPT ALONG SOUTH BOUNDARY LINE OF SECTION.
2. IT SHALL BE THE RESPONSIBILITY OF EACH SUBCONTRACTOR TO VERIFY ALL EXISTING UTILITIES AND CONDITIONS PERTAINING TO HIS PHASE OF WORK. IT SHALL ALSO BE THE SUBCONTRACTOR'S RESPONSIBILITY TO CONTACT THE OWNERS OF THE VARIOUS UTILITIES FOR PROPER STAKE LOCATION OF EACH UTILITY BEFORE WORK IS STARTED. THE SUBCONTRACTOR SHALL NOTIFY IN WRITING THE OWNER OR THE ENGINEER OF ANY CHANGES, OMISSIONS, OR ERRORS FOUND ON THESE PLANS OR IN FIELD BEFORE WORK IS STARTED OR RESUMED.
3. STANDARD SPECIFICATIONS FOR THE CITY OF NOBLESVILLE, INDIANA SHALL APPLY FOR ALL SEWERS.
4. ANY PART OF THE SANITARY OR STORM SEWER TRENCHES RUNNING UNDER PAVED AREAS TO BE BACKFILLED WITH GRANULAR MATERIAL.
5. THE SIZE AND LOCATION OF EXISTING UTILITIES SHOWN ARE PER INFORMATION PROVIDED BY THE RESPECTIVE UTILITY COMPANIES. ALL UTILITY COMPANIES SHOULD BE NOTIFIED PRIOR TO ANY EXCAVATION FOR FIELD LOCATION OF SERVICES.
6. SERVICE WALKS SHALL BE NON-REINFORCED CONCRETE 4" THICK AND 4' IN WIDTH.
7. 4' CONCRETE SERVICE WALK ACROSS FRONTAGE OF EACH LOT TO BE CONSTRUCTED BY OTHERS.
8. TEMPORARY TRAFFIC CONTROL DURING CONSTRUCTION TO CONFORM TO APPLICABLE LOCAL AND STATE STANDARDS.
9. ALL CONSTRUCTION ACTIVITY ON THIS SITE TO BE PERFORMED IN COMPLIANCE WITH APPLICABLE O.S.H.A STANDARDS FOR WORKER SAFETY.
10. CONTRACTOR SHALL MINIMIZE DAMAGE TO EXISTING TREES.

UTILITIES

ELECTRIC	WATER
PUBLIC SERVICE INDIANA 100 MILL CREEK ROAD NOBLESVILLE, INDIANA 46060 (317) 773-1980	INDIANA CITIES WATER 835 WAYNE NOBLESVILLE, INDIANA 46060 (317) 773-2861
CABLE TV	STORM SEWER
INSIGHT COMMUNICATION CO. 694 LOGAN STREET NOBLESVILLE, INDIANA 46060 (317) 776-0660	CITY OF NOBLESVILLE 16 SOUTH 10th STREET NOBLESVILLE, INDIANA 46060 (317) 776-6325
GAS	SANITARY SEWER
P.S.I. ENERGY 100 MILL CREEK ROADROAD NOBLESVILLE, INDIANA 46[illegible] (317) 773-1980	CITY OF NOBLESVILLE 16 SOUTH 10th STREET NOBLESVILLE, INDIANA 46060 (317) 776-6325
STREETS	TELEPHONE
CITY OF NOBLESVILLE 16 SOUTH 10th STREET NOBLESVILLE, INDIANA 46060 (317) 776-6325	INDIANA BELL TELEPHONE CO. 9858 NORTH COLLEGE AVE. INDIANAPOLIS, INDIANA 46220 (317) 265-5878 or 1-800-382-5544

UTILITY HOTLINE: WITHIN INDIANA: 1-800-382-5544
OUTSIDE INDIANA: 1-800-428-5200

NOTE

The size and location of utilities are per plans and locations provided by the respective utility companies. All utility companies shall be notified prior to any excavation for field location of services.

SANITARY SEWER SCHEDULE

STR #	STA	OFFSET LT/RT	TYPE	TC	INVERTS
N/A	14+67.94 'A'	35.29' RT	LIFT STATION	774.30	759.98 (E) 753.98 WET WELL
1	16+26.07 'A'	28.00' RT	MANHOLE	773.50	760.90 (N) [illegible].00 (S) 762.60 (E) 760.70 (W)
2	3+25.53 'B'	28.00'LT	MANHOLE	774.00	762.[illegible].50 (N) 762.70 (E)
3	4+55.93 'B'	28.00' LT	MANHOLE	77[illegible]	[illegible].34 (NE)
4	5+91.73 'B'	28.00' LT	MANHOLE	[illegible]	764.01 (SW) 764.[illegible]
5	6+21.74 'B'	32.20' LT	MANHOLE	779.50	765.21
6	2+79.64 'C'	28.00' LT	MANHOLE	[illegible].50	[illegible].00 (E)
7	4+23.41 'C'	28.00' RT	MANHOLE	[illegible].20	[illegible].66 (W)
8	20+18.91 'A'	28.00' RT	MANHOLE	780.70	773.60 (W) 774.30 (E)
9	22+38.23 'A'	28.00' RT	MANHOLE	784.80	777.37 (SE) 777.17 (W) 777.37 (NE)
10	1+95.39	28.14' RT	MANHOLE	785.10	778.73 (SW)
11	23+28.16	28.20' LT	MANHOLE	784.50	777.87 (NW) 777.97 (S) 8"STUB
12	16+24.60 'A'	138.32' RT	MANHOLE	774.20	761.40 (N) 761.50 (S) 8"STUB
EX1			EXISTING MANHOLE	776.20	771.42 (NW) 8" PVC, 771.42 4" FORCE MAIN

NOT APPLICABLE SEE PROFILE SHEETS

This information was gathered for input into the Hamilton County Geographical Information System. This document is considered an official record of the GIS.
Entry Date: 12-12-03
Entered by: DDH

DRY DETENTION AREA
100 YEAR ELEV=771.80
(FOR DETAILS SEE SHEET S-11)

(ASSUMED NORTH)
SCALE: 1"=50'

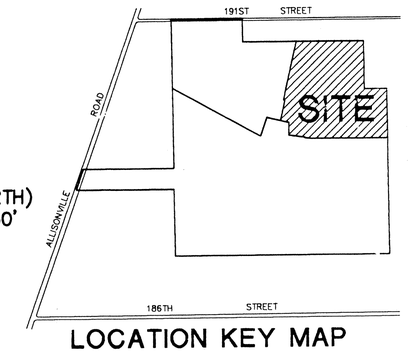

LOCATION KEY MAP

BENCH MARK

BM STATE HIGHWAY BM HAM G2. SOUTHEAST CORNER 186 th AND ALLISONVILLE DISK IN CONCRETE.

ELEVATION = 771.47

TBM I. PIN IN 4" X 4" CONCRETE MONUMENT SOUTHEAST CORNER 186 th AND ALLISONVILLE. 15 FEET NORTH AND 15 FEET EAST OF R/W MARKER.

ELEVATION = 770.50

HOLEY MOLEY SAYS,
"DON'T DIG BLIND"

1-800-382-5544
CALL TOLL FREE
1-800-428-5200
FOR CALLS OUTSIDE OF INDIANA

LEGEND

- Existing Storm Sewer
- New Storm Sewer
- Existing Sanitary Sewer
- New Sanitary Sewer
- Existing Contour
- 000" Existing Elevation
- (000.00) New Pavement Elevations
- 000.00 All Other Finish Elevations
- (000.00) Corrected Elevations
- (SW) Storm Structure Number
- (S) Sanitary Structure Number
- Flow Arrow
- 000.0 Denotes Elevation and Approximate Pad Size

REVISIONS

BY	DATE	CHECK	
			REVISED LOCATION OF PAVED DITCH, REVISED STM. AND SAN. TABLES
C.A.R.	6/23/98		REVISED T.C.'s & ELEVATIONS
			REVISED ESMT'S RELOCATED PADS

DRAWN BY: M.G.B. DATE: 7/29/91

SCHNEIDER ENGINEERING CORPORATION
civil engineers
land surveyors
3020 NORTH POST RD. O
INDIANAPOLIS, INDIANA 46226-6518
(317) 898-8282
P.O. BOX 28068

JOB NO. 708.02
SCALE: AS NOTED

PROJECT: FIELD FARMS SECT. 2
PREPARED FOR: THOMPSON LAND CO., INC.
TITLE: DEVELOPMENT PLAN

FILE
SEP 11 1997
OFFICE OF HAMILTON COUNTY SURVEYOR

STORM SEWER RECORD DRAWING

SHEET 3 OF 18

This copy printed from the original drawing on file in the County Surveyor's Office; One Hamilton Co. Square, Ste. 188, Noblesville, In 46060

GENERAL NOTES:

1. ALL CUTS ARE TAKEN FROM THE EXISTING GRADE TO THE PIPE INVERT.
2. ALL STATIONING IS TAKEN FROM THE NEAREST DOWNSTREAM STRUCTURE.
3. IT SHALL BE THE CONTRACTORS RESPONSIBILITY TO FIELD VERIFY ALL UTILITY LOCATIONS BEFORE CONSTRUCTION BEGINS.
4. TEMPORARY TRAFFIC CONTROL DURING CONSTRUCTION TO CONFORM TO APPLICABLE LOCAL AND STATE STANDARDS.
5. ALL CONSTRUCTION ACTIVITY ON THIS SITE TO BE PERFORMED IN COMPLIANCE WITH APPLICABLE O.S.H.A. STANDARDS FOR WORKER SAFETY.
6. CONTRACTOR SHALL MINIMIZE DAMAGE TO EXISTING TREES.
7. FOR LOCATION OF STRUCTURES SEE DEVELOPMENT PLAN.

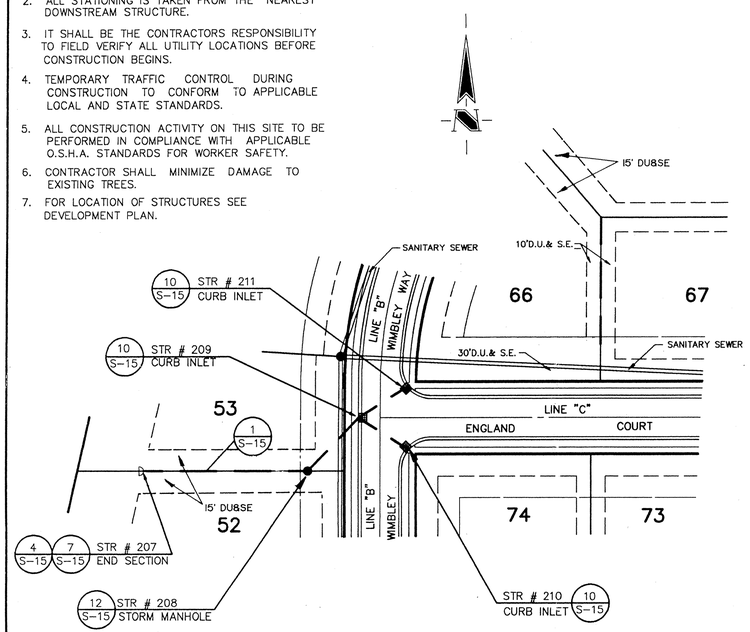

HOLEY MOLEY SAYS,
"DON'T DIG BLIND"

1-800-382-5544
CALL TOLL FREE
1-800-428-5200
FOR CALLS OUTSIDE OF INDIANA

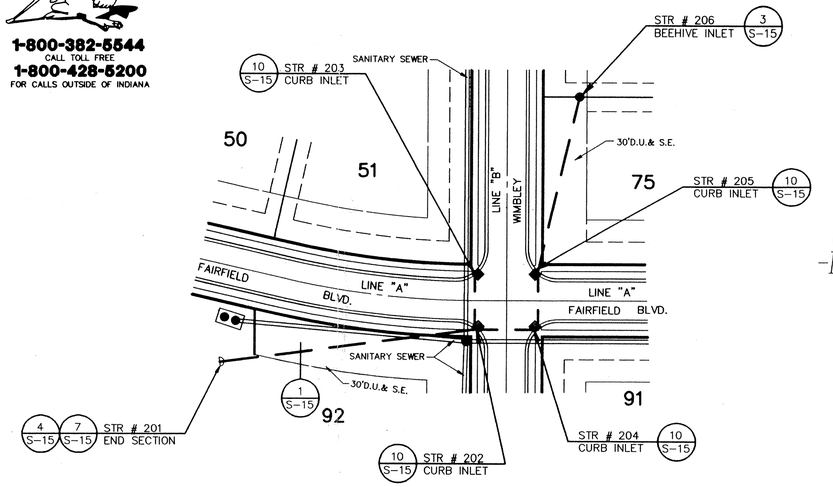

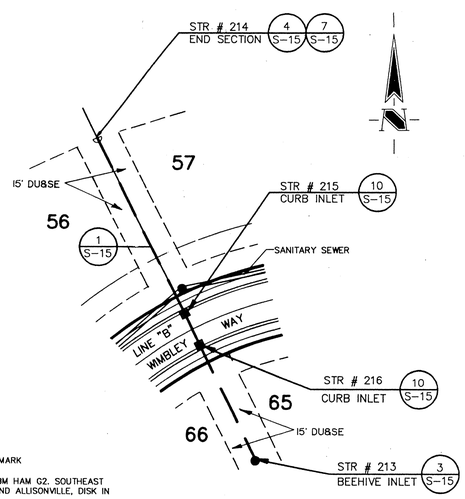

BENCH MARK

BM STATE HIGHWAY BM HAM G2. SOUTHEAST CORNER 186TH AND ALLISONVILLE, DISK IN CONC.

(ELEVATION=771.47)

TBM 1. PIN IN 4" x 4" CONC. MONUMENT SOUTHEAST CORNER 186TH AND ALLISONVILLE, 15 FEET NORTH AND 15 FEET EAST OF R/W MARKER.

(ELEVATION=770.50)

DUANE A. SHAFFER — No. 890258 — REGISTERED PROFESSIONAL ENGINEER — STATE OF INDIANA

REVISIONS

BY	DATE	CHECK	NO.	BY	DATE	CHECK
				C.A.R.	8/21/97	
				C.A.R.	9.4.97	
			3.	T.S.	9/4/97	

REMOVE STR. 212 RELOCATE STR. 213
REVISED ESMT.'S
Storm Sewer Record Drawing.

DRAWN BY PC DATE 7/23/97 CHECK

STORM SEWER PLAN

SCALE: 1"=50'

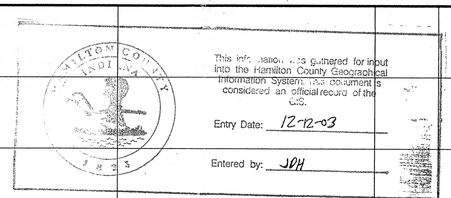

CERTIFICATION FOR "RECORD DRAWING"

CERTIFIED BY: Duane D. Conner

SCHNEIDER ENGINEERING CORPORATION
3020 NORTH POST ROAD
INDIANAPOLIS, INDIANA 46226-0068
(317) 898-8282 FAX (317) 899-8010

NOTE:
Record drawing certification only for top of casting, invert elevations and lengths of pipe. Slope percentage represents a calculated figure and is for general information only.

DUANE D. CONNER — No. LS29500012 — STATE OF INDIANA — LAND SURVEYOR

DATE: 9.5.97

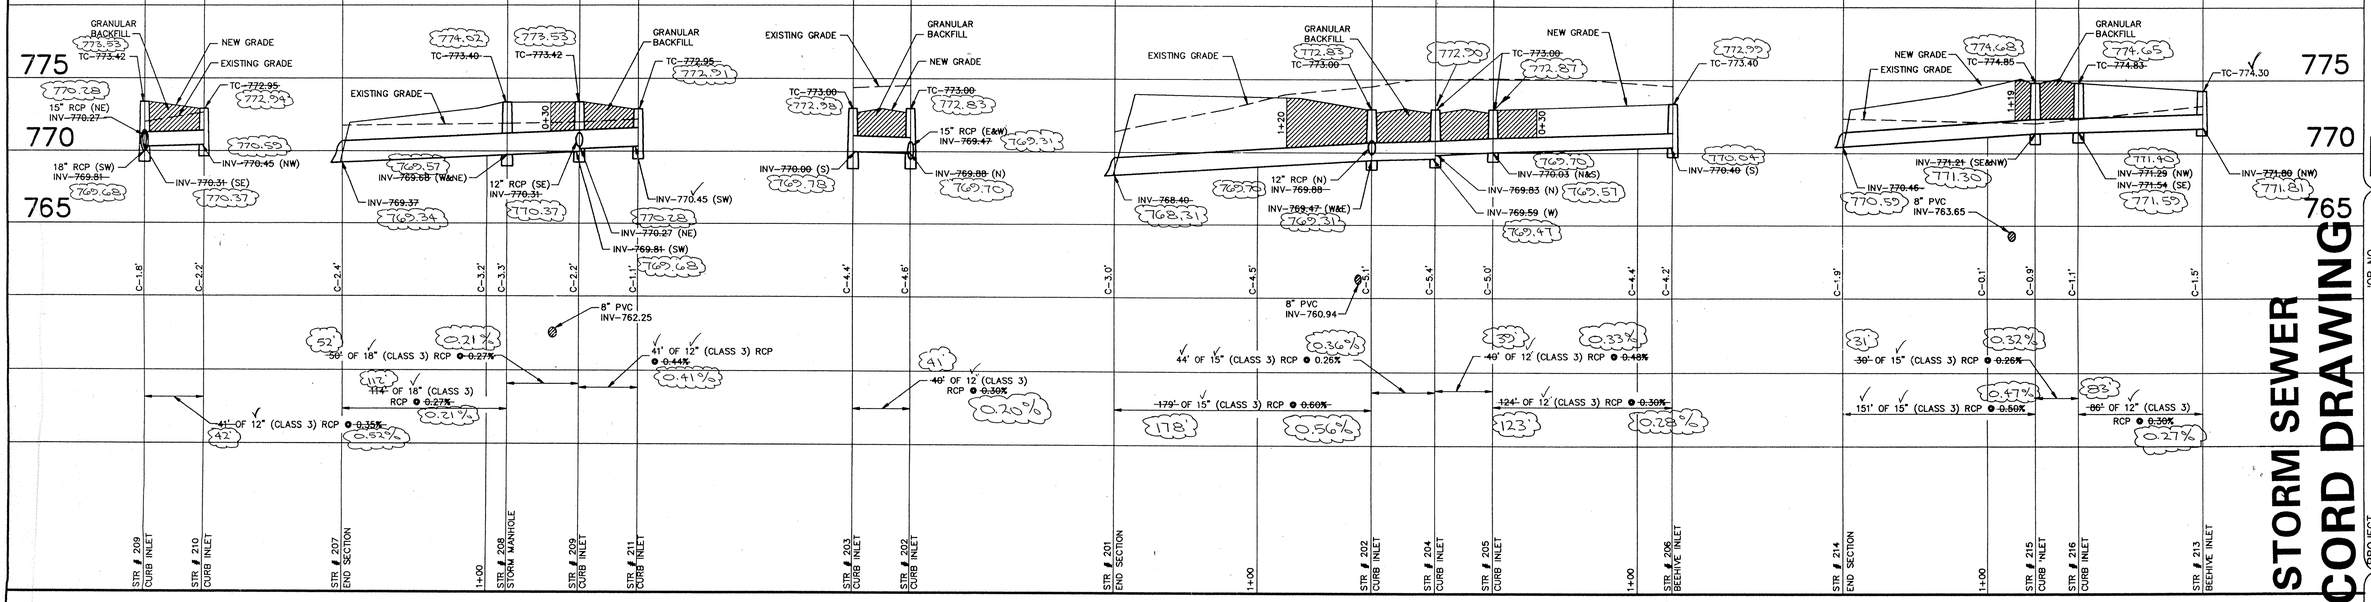

STORM SEWER PROFILE

SCALE: HORIZ.: 1"=50' VERT.: 1"=5'

FILED SEP 11 1997 OFFICE OF HAMILTON COUNTY SURVEYOR

This copy printed from the Digital Archive of the Hamilton County Surveyor's Office: One Hamilton Co. Square, Ste. 188, Noblesville, In 46060

STORM SEWER RECORD DRAWING

PROJECT FAIRFIELD FARMS SECT 2 JOB NO. 708.02
PREPARED FOR THOMPSON LAND COMPANY SCALE: AS NOTED
TITLE STORM SEWER PLAN

SHEET S-9 OF 18

SCHNEIDER ENGINEERING CORPORATION
3020 NORTH POST ROAD
INDIANAPOLIS, INDIANA 46226-6518
(317) 898-8282
P.O. BOX 26068
civil engineers
land surveyors

CERTIFIED 9/10/97

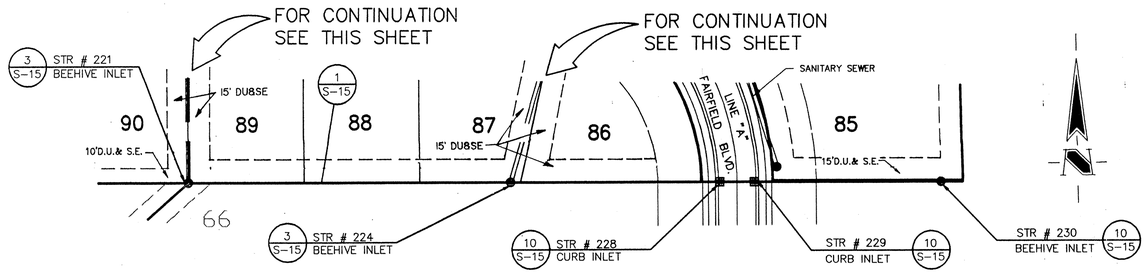

BENCH MARK

BM STATE HIGHWAY BM HAM G2. SOUTHEAST CORNER 186TH AND ALLISONVILLE, DISK IN CONC.

(ELEVATION=771.47)

TBM 1. PIN IN 4" x 4" CONC. MONUMENT SOUTHEAST CORNER 186TH AND ALLISONVILLE. 15 FEET NORTH AND 15 FEET EAST OF R/W MARKER.

(ELEVATION=770.50)

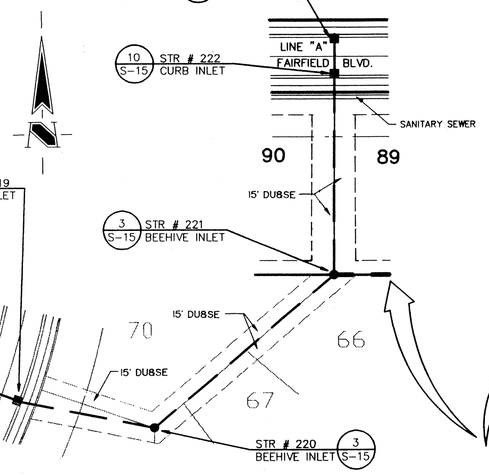

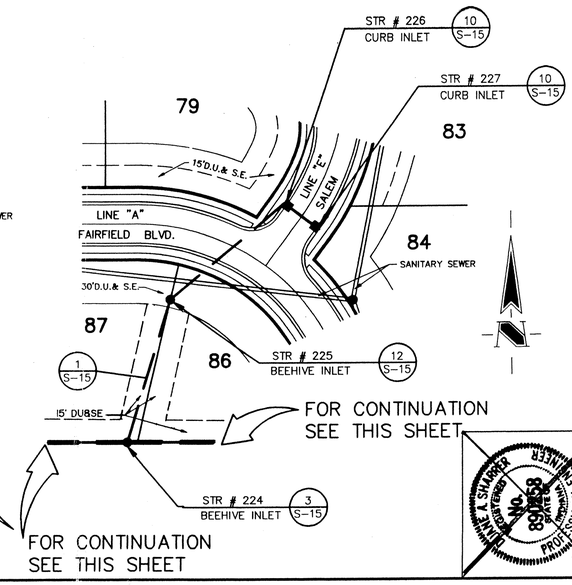

GENERAL NOTES:

1. ALL CUTS ARE TAKEN FROM THE EXISTING GRADE TO THE PIPE INVERT.
2. ALL STATIONING IS TAKEN FROM THE NEAREST DOWNSTREAM STRUCTURE.
3. IT SHALL BE THE CONTRACTORS RESPONSIBILITY TO FIELD VERIFY ALL UTILITY LOCATIONS BEFORE CONSTRUCTION BEGINS.
4. TEMPORARY TRAFFIC CONTROL DURING CONSTRUCTION TO CONFORM TO APPLICABLE LOCAL AND STATE STANDARDS.
5. ALL CONSTRUCTION ACTIVITY ON THIS SITE TO BE PERFORMED IN COMPLIANCE WITH APPLICABLE O.S.H.A. STANDARDS FOR WORKER SAFETY.
6. CONTRACTOR SHALL MINIMIZE DAMAGE TO EXISTING TREES.
7. FOR LOCATION OF STRUCTURES SEE DEVELOPMENT PLAN.

HOLEY MOLEY SAYS,
"DON'T DIG BLIND"

1-800-382-5544
CALL TOLL FREE
1-800-428-5200
FOR CALLS OUTSIDE OF INDIANA

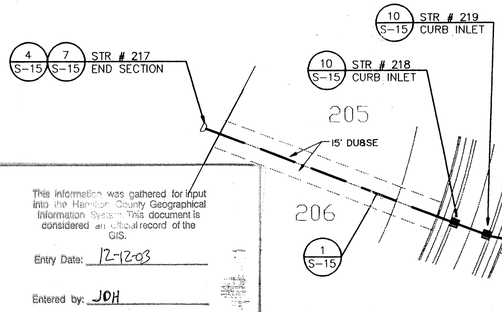

This information was gathered for input into the Hamilton County Geographical Information System. This document is considered an official record of the GIS.
Entry Date: 12-12-03
Entered by: JDH

STORM SEWER PLAN

SCALE: 1"=50'

CERTIFICATION FOR "RECORD DRAWING"

CERTIFIED BY:
SCHNEIDER ENGINEERING CORPORATION
3020 NORTH POST ROAD
INDIANAPOLIS, INDIANA 46226-0068
(317) 898-8282 FAX (317) 899-8010

NOTE:
Record drawing certification only for top of casting, invert elevations and lengths of pipe. Slope percentage represents a calculated figure and is for general information only.

DATE: 9.7.97


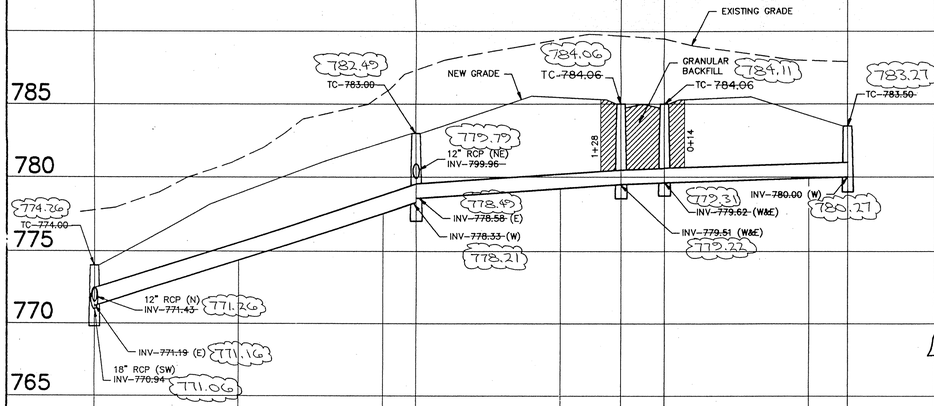

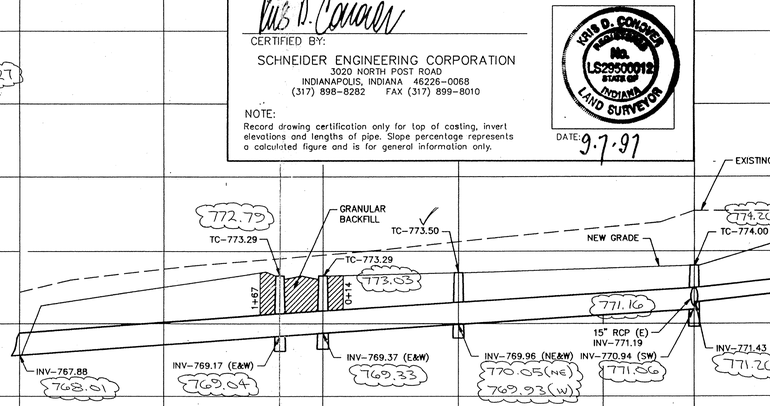

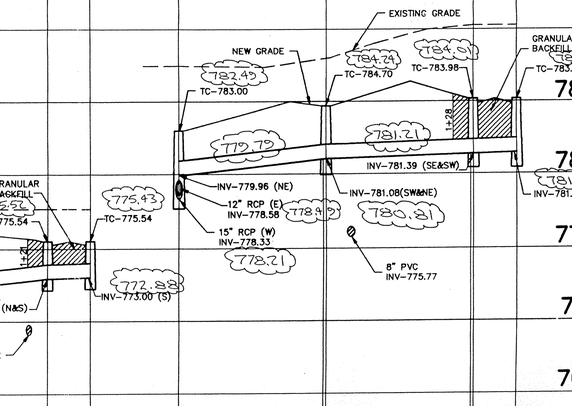

STORM SEWER
RECORD DRAWING

STORM SEWER PROFILE

SCALE: HORIZ.: 1"=50'
VERT.: 1"=5'

This copy printed from the Digital Archive of the Hamilton County Surveyor's Office; One Hamilton Co. Square, Ste. 188, Noblesville, In 46060

FILED
SEP 11 1997
OFFICE OF HAMILTON COUNTY SURVEYOR

REVISIONS

BY	DATE	CHECK	NO.	BY	DATE	CHECK
				C.A.R.	2/21/97	
				C.A.R.	3/24/97	

REVISED ESMT.'S
REVISED ESMT.'S

DRAWN BY PC DATE 7/25/96 CHECK

REVISED ELEVATIONS AND T.C.'s BETWEEN STR.224 & STR. 227
Sewer Sizes Record Drawing

CERTIFIED

SCHNEIDER ENGINEERING CORPORATION
3020 NORTH POST ROAD
INDIANAPOLIS, INDIANA 46226-6518
(317) 898-8282
P.O. BOX 26383
civil engineers
land surveyors

PROJECT FAIRFIELD FARMS SECT 2
PREPARED FOR THOMPSON LAND COMPANY
TITLE STORM SEWER PLAN
JOB NO. 708.02
SCALE: AS NOTED

SHEET S-10 OF 18